

PIKE

MISSISSIPPI
BOARD OF WATER COMMISSIONERS
416 North State Street
Jackson, Mississippi 39201

K 2030

WATER WELL DRILLERS LOG

9707-79

Sept 7 1979

79 River well in

Pike

date well completed

firm name

county well located

LANDOWNER:	description of formations encountered	from	to
Hughes Gray	clay	0	13
Rt asyba (mailing address)	sand hollow sand	13	20
	yellow chalk	20	28
	sand	28	62
WELL LOCATION:			
sec 24 T 1 N R 7 E			
1 1/2 miles South of Chatom			
WELL PURPOSE: home			
(home, irrigation, municipal, industrial)			
WELL COMPLETION DATA:			
(1) diameter (inches) 4"			
(2) total depth (feet) 62			
(3) static water level (feet) 25' below top of ground			
(4) casing plastic bottom			
(5) screen 5' 5'			
(6) pump 4" plastic			
(7) electric log no			
(8) how well bottom plugged wooden plug			
DRILLERS REMARKS:			


DEPT. OF NATURAL RESOURCES
BUREAU OF LAND & WATER RESOURCES

JUN 25 1980

RECEIVED

If well telescopes please sketch and show depths.

GROUND LEVEL

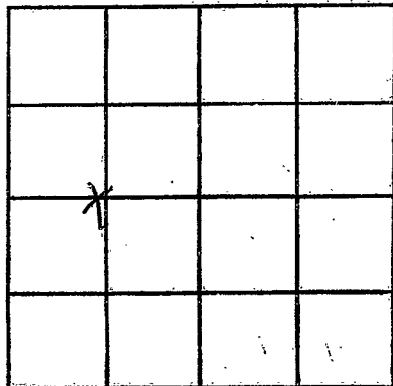

SECTION 24

Please indicate well location X.

ADDITIONAL INFORMATION

If more than one screen, show locations of each on sketch.