

Pike
 K 2032
 12-7-79

MISSISSIPPI
 BOARD OF WATER COMMISSIONERS
 416 North State Street
 Jackson, Mississippi 39201

WATER WELL DRILLERS LOG

12-7-79 date well completed 1979 F. J. ... firm name Pike county well located

LANDOWNER:
 Charles Addison

description of formations encountered

description of formations encountered	from	to
Red clay	0	20
Red sand	20	60
Coarse sand & gravel	60	65
White chalk	65	175
Coarse sand & gravel	175	190

WELL LOCATION:
 sec. 30 T. 1 N. S. R. 7 E. W.
 5 1/2 miles W of Osyka
 (distance) (direction) (nearest town)

WELL PURPOSE:
 Home
 (home, irrigation, municipal, industrial)

WELL COMPLETION DATA:

(1) diameter (inches) 4

(2) total depth (feet) 190

(3) static water level (feet) 45 below top of ground.

(4) casing PVC, 182 (depth)
 4 (size) if telescope see back.

(5) screen 8, 182 (length) (depth to top)
 4 (size) PVC (material)

(6) pump 1/2 (HP) 10 (yield gpm)
 Elec (type power)

(7) electric log No (yes or no)
 (organization running log)


(8) how well bottom plugged Sand Shale

DRILLERS REMARKS:

DEPT. OF NATURAL RESOURCES
 BUREAU OF LAND & WATER RESOURCES
 JAN 31 1980
 RECEIVED

If well telescopes please sketch and show depths.

GROUND LEVEL

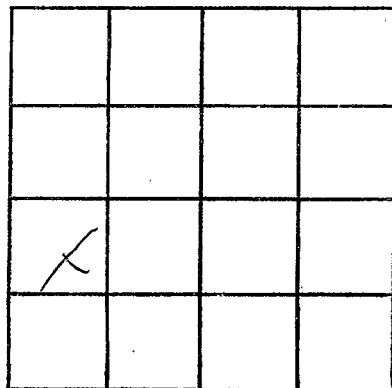

SECTION 30

Please indicate well location X.

ADDITIONAL INFORMATION

If more than one screen,
show locations of each on sketch.