

Pike
K 2023
7-11-80

MISSISSIPPI
BOARD OF WATER COMMISSIONERS
416 North State Street
Jackson, Mississippi 39201

WATER WELL DRILLERS LOG

7-11 1980 Jewell well ser. Pike
date well completed firm name county well located

LANDOWNER:	description of formations encountered	from	to
Jewell Clark R.R. Macrobie (mailing address)			
	Red sand	20	120
	Coarse sand & gravel	120	130

WELL LOCATION:
sec. 1 T. 1 N. R. 7 E.
1 miles W of Centerville
(distance) (direction) (nearest town)

WELL PURPOSE: Home
(home, irrigation, municipal, industrial)

- WELL COMPLETION DATA:
- (1) diameter (inches) 4
 - (2) total depth (feet) 170
 - (3) static water level (feet) 65 below top of ground.
 - (4) casing 4 122
(material) (depth)
4 if telescope see back.
(size)
 - (5) screen 8 122
(length) (depth to top)
4 PVC
(size) (material)
 - (6) pump 1/2 10
(HP) (yield gpm)
Electric
(type power)
 - (7) electric log No
(yes or no)
 - (8) how well bottom plugged Good


DRILLERS REMARKS:

DEPT. OF NATURAL RESOURCES
BUREAU OF LAND & WATER RESOURCES

SEP 8 - 1980
RECEIVED

If well telescopes please sketch and show depths.

GROUND LEVEL

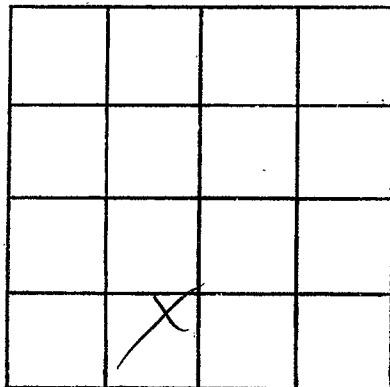

SECTION /

Please indicate well location X.

ADDITIONAL INFORMATION

If more than one screen, show locations of each on sketch.