

Pike
K 2034
8-7-80

MISSISSIPPI
BOARD OF WATER COMMISSIONERS
416 North State Street
Jackson, Mississippi 39201

WATER WELL DRILLERS LOG

8-7 1980 Fitzgerald Well Serv Pike
date well completed firm name county well located

LANDOWNER:
T. F. OULT
B. R. Oyster
(mailing address)

description of formations encountered	from	to
<u>Red Clay</u>	<u>0</u>	<u>20</u>
<u>white clay</u>	<u>20</u>	<u>80</u>
<u>Coarse Sand & Gravel</u>	<u>80</u>	<u>95</u>

WELL LOCATION:
sec. 26 T. 1 N. R. 7 E
1 miles N of Oyster
(distance) (direction) (nearest town)

WELL PURPOSE: Home
(home, irrigation, municipal, industrial)

WELL COMPLETION DATA:
(1) diameter (inches) 4
(2) total depth (feet) 95
(3) static water level (feet) 20 below/above top of ground.
(4) casing PVC, 87,
(material) (depth)
4 If telescope see back.
(size)
(5) screen 8, 87
(length) (depth to top)
4, PVC
(size) (material)
(6) pump 3/4, 15
(HP) (yield gpm)
also
(type power)
(7) electric log yes
(yes or no)
(organization running log)
(8) how well bottom plugged Seal block


DRILLERS REMARKS:

DEPT. OF NATURAL RESOURCES
BUREAU OF LAND & WATER RESOURCES

SEP 8 - 1980
RECEIVED

If well telescopes please sketch and show depths.

GROUND LEVEL

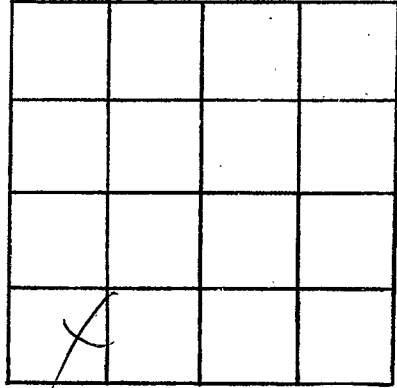

SECTION 26

Please indicate well location X.

ADDITIONAL INFORMATION

If more than one screen, show locations of each on sketch.