

Bureau of Land and Water Resources
 Southport Mall
 P.O. Box 10631
 Jackson, Mississippi 39209
WATER WELL DRILLERS LOG

PIKE
K 2036
10-13-80
Oct 13 1980


Newsuller Pike

date well completed

firm name

county well located


LANDOWNER:	description of formations encountered	from	to
(mailing address)			
<u>Jim Cature</u>	<u>Red Clay</u>	<u>0</u>	<u>17</u>
<u>no address</u>	<u>Red sand</u>	<u>17</u>	<u>85</u>
	<u>Gravel</u>	<u>85</u>	<u>90</u>
	<u>plastic lobbly</u>	<u>90</u>	<u>140</u>
	<u>& Chalk</u>	<u>90</u>	<u>140</u>
	<u>plagrand sand</u>	<u>140</u>	<u>155</u>
WELL LOCATION:			
sec. <u>12</u> T. <u>1</u> N R. <u>7</u> E			
<u>3</u> miles <u>West</u> of <u>Aspya</u>			
(distance) (direction) (nearest town)			
WELL PURPOSE: <u>home</u>			
(home, irrigation, municipal, industrial)			
WELL COMPLETION DATA:			
(1) diameter (inches) <u>4"</u>			
(2) total depth (feet) <u>155'</u>			
(3) static water level (feet) <u>97'</u> below top of ground.			
(4) casing <u>plastic bottom</u> (material) (depth)			
<u>—</u> (size) if telescope see back.			
(5) screen <u>5'</u> (length) <u>150'</u> (depth to top)			
<u>4"</u> (size) <u>plastic</u> (material)			
(6) pump <u>1/2</u> (HP) <u>other</u> (yield gpm)			
<u>shot</u> (type power)			
(7) electric log <u>no</u> (yes or no)			
(organization running log)			
(8) how well bottom plugged <u>Bottom valve</u>			

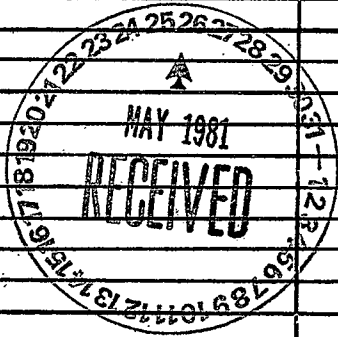

DRILLERS REMARKS:

If well telescopes please sketch and show depths.

GROUND LEVEL

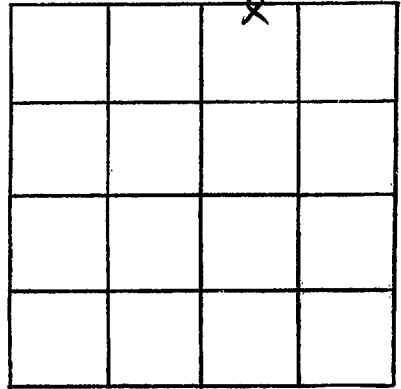

SECTION 15

Please indicate well location X.

ADDITIONAL INFORMATION

If more than one screen, show locations of each on sketch.