

Pike  
 5 2087  
 10/21/80

Bureau of Land and Water Resources  
 Southport Mall  
 P.O. Box 10631  
 Jackson, Mississippi 39209  
**WATER WELL DRILLERS LOG**

Oct 21 1980 Reena Miller Pike  
 date well completed firm name county well located

**LANDOWNER:**  
J. T. Smith  
Rt. Osyka  
 (mailing address)

description of formations encountered	from	to
	<u>sandy clay</u>	<u>0</u>
<u>yellow sand</u>	<u>16</u>	<u>60</u>
<u>fine gravel</u>	<u>60</u>	<u>85</u>
<u>fine sand &amp; (sand blocks)</u>	<u>85</u>	<u>195</u>
<u>coarse sand &amp; pea gravel</u>	<u>195</u>	<u>213</u>

**WELL LOCATION:**  
 sec. 25 T 1 N R 7 E  
8 miles South of Magalloway  
 (distance) (direction) (nearest town)

**WELL PURPOSE:** Home  
 (home, irrigation, municipal, industrial)


- WELL COMPLETION DATA:**
- (1) diameter (inches) 4"
  - (2) total depth (feet) 213
  - (3) static water level (feet) 70 ~~above~~ below top of ground.
  - (4) casing plastic, bottom  
 (material) (depth)  
 (size) if telescope see back.
  - (5) screen 5" 208'  
 (length) (depth to top)  
4" plastic  
 (size) (material)
  - (6) pump ag Arthur  
 (HP) (yield gpm)  
elect  
 (type power)
  - (7) electric log no  
 (yes or no)  
 (organization running log)
  - (8) how well bottom plugged  
back mesh

**DRILLERS REMARKS:**  
 \_\_\_\_\_  
 \_\_\_\_\_



If well telescopes please sketch and show depths.

GROUND LEVEL

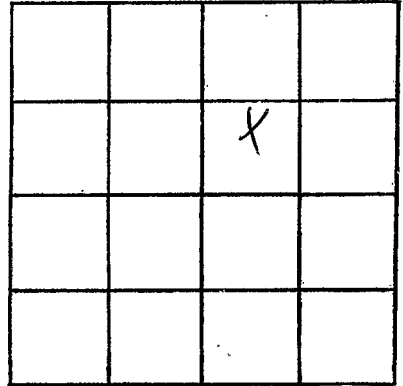

SECTION 25

Please indicate well location X.

ADDITIONAL INFORMATION

If more than one screen, show locations of each on sketch.