


Pto  
K 203A  
5-15-81

MISSISSIPPI  
BOARD OF WATER COMMISSIONERS  
416 North State Street  
Jackson, Mississippi 39201

WATER WELL DRILLERS LOG


515 19 81 Fit good well serv Pike  
date well completed firm name county well located

LANDOWNER:	description of formations encountered	from	to
<u>E. W. Hilburn</u>			
<u>R.R. Oster - M.</u> (mailing address)	<u>Red Clay</u> <u>Red Sand</u> <u>Coarse Sand &amp; Gravel</u>	<u>0</u> <u>10</u> <u>60</u>	<u>10</u> <u>60</u> <u>71</u>
<b>WELL LOCATION:</b>			
sec. <u>30</u> T <u>1</u> N R <u>7</u> E S W			
<u>4</u> miles <u>W</u> of <u>Rayburn</u> (distance) (direction) (nearest town)			
<b>WELL PURPOSE:</b> (home, irrigation, municipal, industrial)			
<b>WELL COMPLETION DATA:</b>			
(1) diameter (inches) <u>4</u>			
(2) total depth (feet) <u>71</u>			
(3) static water level (feet) <u>25</u> below top of ground. above			
(4) casing <u>PVC</u> , <u>63</u> , (material) (depth) <u>4</u> If telescope see back. (size)			
(5) screen <u>8</u> , <u>63</u> (length) (depth to top)			
(6) pump <u>4</u> , <u>PVC</u> (size) (material)			
(6) pump <u>1/2</u> , <u>10</u> (HP) (yield gpm)			
<u>elm</u> (type power)			
(7) electric log <u>no</u> (yes or no)			
(8) how well bottom plugged <u>Good</u>			
<b>DRILLERS REMARKS:</b>			

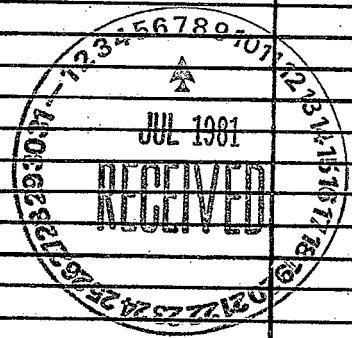

If well telescopes please sketch and show depths.

GROUND LEVEL

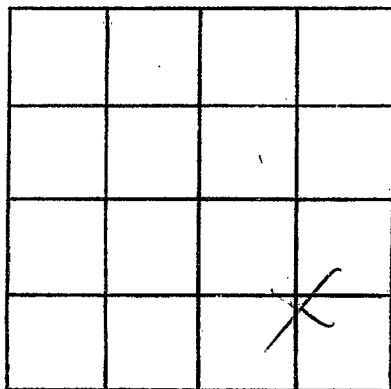

SECTION 30

Please indicate well location X.

ADDITIONAL INFORMATION

If more than one screen,  
show locations of each on sketch.