

Pike
K 2040
5-11-81

MISSISSIPPI
BOARD OF WATER COMMISSIONERS
416 North State Street
Jackson, Mississippi 39201

WATER WELL DRILLERS LOG

5-11
date well completed

1981

Fitzgerald Well Serv
firm name


Pike
county well located

LANDOWNER:	description of formations encountered	from	to
Walter Fagan	Reel clay	0	20
RR - Magnolia (mailing address)	Reel sand Fine sand & clay gravel Coarse sand & gravel	20 80 120	80 120 130
WELL LOCATION: sec. <u>1</u> T <u>1</u> N R <u>2</u> E S W <u>5</u> miles <u>S</u> of <u>Magnolia</u> (distance) (direction) (nearest town)			
WELL PURPOSE: <u>Home</u> (home, irrigation, municipal, industrial)			
WELL COMPLETION DATA: (1) diameter (inches) <u>4</u> (2) total depth (feet) <u>130</u> (3) static water level (feet) <u>75</u> below above top of ground. (4) casing <u>PVC</u> , <u>122</u> , (material) (depth) <u>4</u> If telescope see back. (size) (5) screen <u>8</u> , <u>122</u> (length) (depth to top) <u>4</u> , <u>PVC</u> (size) (material) (6) pump <u>1/2</u> <u>10</u> (HP) (yield gpm) <u>90</u> (type power) (7) electric log <u>no</u> (yes or no) (organization running log) (8) how well bottom plugged <u>Sand plug</u>			
DRILLERS REMARKS:			



If well telescopes please sketch and show depths.

GROUND LEVEL

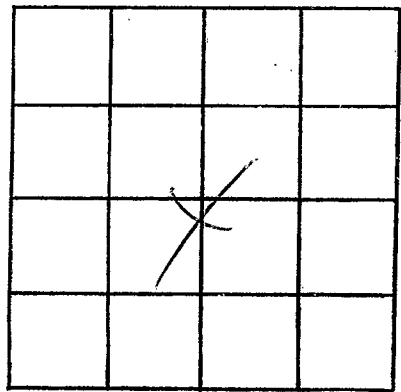

SECTION 1

Please indicate well location X.

ADDITIONAL INFORMATION

If more than one screen, show locations of each on sketch.