

MISSISSIPPI DEPARTMENT OF NATURAL RESOURCES

Bureau of Land and Water Resources

Southport Mall

P.O. Box 10631

Jackson, Mississippi 39209

WATER WELL DRILLERS LOG

Pike
K 204
4-2-81

April 2 1981 Reuss Miller Pike
 date well completed firm name county well located

LANDOWNER:
Jim Wicks
Rt asyba.
 (mailing address)


description of formations encountered	depth	
	from	to
<u>Clay</u>	<u>0</u>	<u>12</u>
<u>Sand</u>	<u>12</u>	<u>20</u>
<u>Red Chalk</u>	<u>20</u>	<u>38</u>
<u>Sand + small gravel</u>	<u>38</u>	<u>65</u>
<u>Chalky tubble</u>	<u>65</u>	<u>80</u>
<u>pea gravel</u>	<u>80</u>	<u>90</u>

WELL LOCATION:
 sec. 7 T. 1 N. R. 7 E.
6 miles W.S.W of Magnolia
 (distance) (direction) (nearest town)

WELL PURPOSE:
 (home, irrigation, municipal, industrial)


- WELL COMPLETION DATA:
- (1) diameter (inches) 4"
 - (2) total depth (feet) 90"
 - (3) static water level (feet) 66' below above top of ground.
 - (4) casing plastic bottom
 (material) (depth)
 - _____ if telescope see back.
 (size)
 - (5) screen 5' 85'
 (length) (depth to top)
 - _____ plastic
 (size) (material)
 - (6) pump by others
 (HP) (yield gpm)
 - _____ skt
 (type power)
 - (7) electric log no
 (yes or no)
 - _____ (organization running log)
 - (8) how well bottom plugged beck wash

DRILLERS REMARKS:

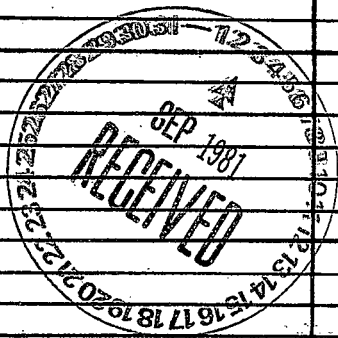

If well telescopes please sketch and show depths.

GROUND LEVEL

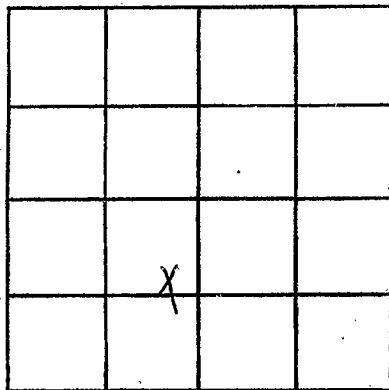

SECTION 7

Please indicate well location X.

ADDITIONAL INFORMATION

If more than one screen,
show locations of each on sketch.