

Pike
K 2043
8-26-81

MISSISSIPPI
 BOARD OF WATER COMMISSIONERS
 416 North State Street
 Jackson, Mississippi 39201

WATER WELL DRILLERS LOG

8-26 1981 Flounders Inc Pike
 date well completed firm name county well located

LANDOWNER:
CONVENT

description of formations encountered

from	to
0	20
30	60
60	100
100	116

St. Mark of the Indies
CHATAWA - (mailing address)

Red clay
Red gravel
White chalk
Course sand

WELL LOCATION:
 sec 11 T 1 (N) R 2 (E)
1 miles E of CHATAWA
 (distance) (direction) (nearest town)

WELL PURPOSE: Home
 (home, irrigation, municipal, industrial)

WELL COMPLETION DATA:

- (1) diameter (inches) 4
- (2) total depth (feet) 116
- (3) static water level (feet) 35 below above ground.
- (4) casing PVC 108
 (material) (depth)
4 If telescope see back.
 (size)
- (5) screen 8 108
 (length) (depth to top)
4 PVC
 (size) (material)
- (6) pump 1 20
 (HP) (yield gpm)
Electric
 (type power)
- (7) electric log no
 (yes or no)
(organization running log)
- (8) how well bottom plugged Seal off


DRILLERS REMARKS:

DEPT. OF NATURAL RESOURCES
 BUREAU OF LAND & WATER RESOURCES

SEP 28 1981
 RECEIVED

If well telescopes please sketch and show depths.

GROUND LEVEL

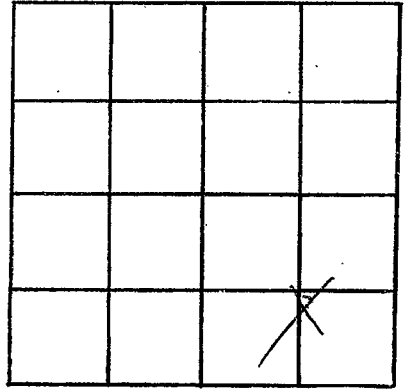

SECTION 11

Please indicate well location X.

ADDITIONAL INFORMATION

If more than one screen, show locations of each on sketch.