

*Pike*  
 K  
 2045

MISSISSIPPI  
 BOARD OF WATER COMMISSIONERS  
 416 North State Street  
 Jackson, Mississippi 39201

WATER WELL DRILLERS LOG

1-27  
 date well completed

1982 Fitzgerald Well Serv  
 firm name

Pike  
 county well located

LANDOWNER:	description of formations encountered	from	to
Homer Adobson RR. Osyka, Ms. (mailing address)			
WELL LOCATION:			
sec. 28 T 1 N R 2 E S W W			
4 miles W of Osyka (distance) (direction) (nearest town)			
WELL PURPOSE:			
Home (home, irrigation, municipal, industrial)			
WELL COMPLETION DATA:			
(1) diameter (inches) 4			
(2) total depth (feet) 170			
(3) static water level (feet) 70 below top of ground.			
(4) casing PVC, 162 (material) (depth) 4 If telescope see back. (size)			
(5) screen 8, 162 (length) (depth to top) 4 PVC (size) (material)			
(6) pump 1/2 10 (HP) (yield gpm) electric (type power)			
(7) electric log No (yes or no)			
(organization running log)			
(8) how well bottom plugged <i>Seal plug</i>			
DRILLERS REMARKS:			


DEPT. OF NATURAL RESOURCES  
 BUREAU OF LAND & WATER RESOURCES

MAR 10 1982

RECEIVED

If well telescopes please sketch and show depths.

GROUND LEVEL

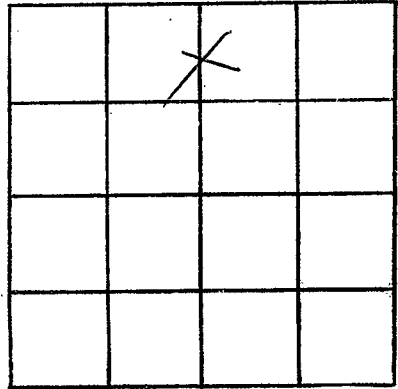

SECTION 28

Please indicate well location X.

ADDITIONAL INFORMATION

If more than one screen,  
show locations of each on sketch.