

MISSISSIPPI DEPARTMENT OF NATURAL RESOURCES

Bureau of Land and Water Resources

Southport Mall

P.O. Box 10631

Jackson, Mississippi 39209

WATER WELL DRILLERS LOG

PIKE
K
2047

July 7 1982 Reussmiller Pike
date well completed firm name county well located

LANDOWNER:
Grace Madarige
Rt. 2500a
(mailing address)

description of formations encountered	from	to
Red sandy clay	0	25
Red sand	25	60
per gravel & sand	60	90
Red Chalk	90	102
lighty sand	102	120
white Chalk	120	135
fine sand	135	170
per gravel	170	180

WELL LOCATION:
sec 20 T 1 N R 7 E
5 miles SW of alpha
(distance) (direction) (nearest town)

WELL PURPOSE: water
(home, irrigation, municipal, industrial)

WELL COMPLETION DATA:

(1) diameter (inches) 4"

(2) total depth (feet) 180

(3) static water level (feet) 85' below top of ground.

(4) casing plastic bottom
(material) (depth)

(5) screen 5' 175'
(length) (depth to top)

(6) pump 4" plastic
(size) (material)

(7) pump 1/2 10
(HP) (yield gpm)

(8) electric log no
(yes or no)

(organization running log)

(8) how well bottom plugged back dash

DEPT. OF NATURAL RESOURCES
BUREAU OF LAND & WATER RESOURCES


NOV 21 1982

RECEIVED

DRILLERS REMARKS:

If well telescopes please sketch and show depths.

GROUND LEVEL

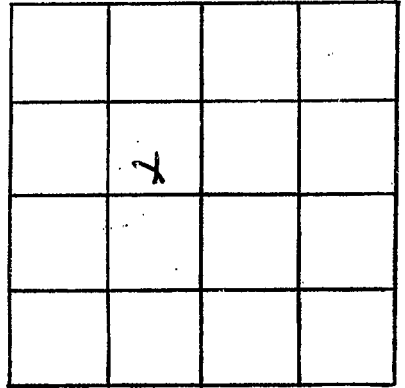

SECTION 20

Please indicate well location X.

ADDITIONAL INFORMATION

If more than one screen,
show locations of each on sketch.