

MISSISSIPPI DEPARTMENT OF NATURAL RESOURCES

Bureau of Land and Water Resources

Southport Mall

P.O. Box 10631

Jackson, Mississippi 39209

WATER WELL DRILLERS LOG

PIKE
K
2048

June 26 1982 James Miller Pike  
 date well completed firm name county well located

LANDOWNER:  
Carl Donaldson  
Mt. Magnolia  
 (mailing address)

WELL LOCATION:  
 sec. 11 T. 1 N. R. 7 E  
in miles Chattanooga  
 (distance) (direction) (nearest town)

WELL PURPOSE: house  
 (home, irrigation, municipal, industrial)

WELL COMPLETION DATA:

(1) diameter (inches) 4"

(2) total depth (feet) 180

(3) static water level (feet) 65' below top of ground.

(4) casing steel, bottom  
 (material) (depth)

— if telescope see back.  
 (size)

(5) screen 5', 175'  
 (length) (depth to top)

4", plastic  
 (size) (material)

(6) pump by other  
 (HP) (yield gpm)

elect  
 (type power)

(7) electric log no  
 (yes or no)

—  
 (organization running log)

description of formations encountered	depth	
	from	to
<u>clay</u>	<u>0</u>	<u>20</u>
<u>brown sand &amp; gravel</u>	<u>20</u>	<u>50</u>
<u>Red Chalk</u>	<u>50</u>	<u>60</u>
<u>brown sand &amp; gravel</u>	<u>60</u>	<u>80</u>
<u>white chalk</u>	<u>80</u>	<u>170</u>
<u>small gravel</u>	<u>170</u>	<u>180</u>

(8) how well bottom plugged each wash

DRILLERS REMARKS:


DEPT. OF NATURAL RESOURCES  
 BUREAU OF LAND & WATER RESOURCES

NOV 22 1982

RECEIVED

If well telescopes please sketch and show depths.

GROUND LEVEL

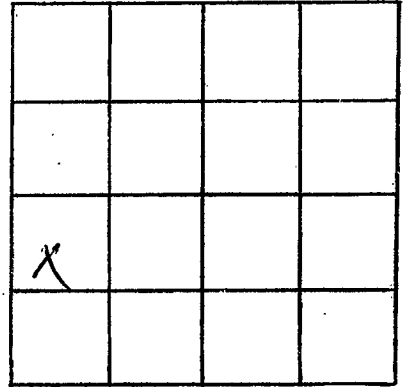

SECTION 11

Please indicate well location X.

ADDITIONAL INFORMATION

If more than one screen,  
show locations of each on sketch.