

MISSISSIPPI DEPARTMENT OF NATURAL RESOURCES

Bureau of Land and Water Resources

Southport Mall

P.O. Box 10631

Jackson, Mississippi 39209

WATER WELL DRILLERS LOG

| |
|------|
| PIKE |
| K |
| 2019 |

June 15 1982 Reems Well Co Pike
 date well completed firm name county well located

LANDOWNER:
 Syvester S. Clapier
 Magnolia
 (mailing address)

| description of formations encountered | from | to |
|---------------------------------------|------|-----|
| sandy clay | 0 | 22 |
| yellow sand | 22 | 80 |
| clay & gravel | 80 | 100 |
| cherty sand | 100 | 122 |
| small gravel | 122 | 138 |

WELL LOCATION:
 sec. 11 T 1 N R 7 E
 1 miles west of Chatman
 (distance) (direction) (nearest town)

WELL PURPOSE: Barn
 (home, irrigation, municipal, industrial)

- WELL COMPLETION DATA:
- (1) diameter (inches) 4"
 - (2) total depth (feet) 138'
 - (3) static water level (feet) 85' below top of ground.
 - (4) casing plastic bottom
 (material) (depth)
 - (size) if telescope see back.
 - (5) screen 5' 133'
 (length) (depth to top)
 - 4" plastic
 (size) (material)
 - (6) pump 3 sub 12
 4 (HP) (yield gpm)
 - 4 hp
 (type power)
 - (7) electric log no
 (yes or no)
 - (organization running log)

(8) how well bottom plugged
 back wash

DRILLERS REMARKS:


DEPT. OF NATURAL RESOURCES
 BUREAU OF LAND & WATER RESOURCES

NOV 22 1982

RECEIVED

If well telescopes please sketch and show depths.

GROUND LEVEL

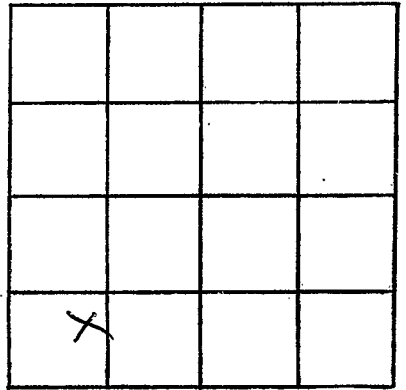

SECTION 11

Please indicate well location X.

ADDITIONAL INFORMATION

If more than one screen, show locations of each on sketch.