

PIKE
K
2080

MISSISSIPPI DEPARTMENT OF NATURAL RESOURCES
Bureau of Land and Water Resources
Southport Mall
P.O. Box 10631
Jackson, Mississippi 39209
WATER WELL DRILLERS LOG

Oct-8 1982 Annex Well Co Pike
date well completed firm name county well located

LANDOWNER:
Lynn Singleton
(Chatama Bluffs)
(mailing address)

description of formations encountered	from	to
Clay	0	15
sand & gravel	15	45
Red sand	45	60
White Chalk	60	75
small gravel	75	93
White Chalk	93	102
sand & pec gravel	102	115

WELL LOCATION:
sec. 2 T. 1 N. R. 7 E
1 miles South of Chatama
(distance) (direction) (nearest town)

WELL PURPOSE: work - office
(home, irrigation, municipal, industrial)

WELL COMPLETION DATA:

(1) diameter (inches) 4"

(2) total depth (feet) 115'

(3) static water level (feet) 70 below above top of ground.

(4) casing plastic, leather
(material) (depth)

 if telescope see back.
(size)

(5) screen 10', 105'
(length) (depth to top)

4", plastic
(size) (material)

(6) pump 1 Sub, 20
(HP) (yield gpm)

elect
(type power)

(7) electric log no
(yes or no)

(organization running log)

(8) how well bottom plugged back wash

DRILLERS REMARKS:


DEPT. OF NATURAL RESOURCES
BUREAU OF LAND & WATER RESOURCES

FEB 24 1983

RECEIVED

If well telescopes please sketch and show depths.

GROUND LEVEL

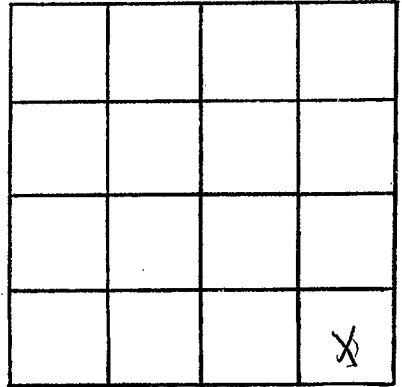

SECTION 2

Please indicate well location X.

ADDITIONAL INFORMATION

If more than one screen,
show locations of each on sketch.