

MISSISSIPPI DEPARTMENT OF NATURAL RESOURCES

Bureau of Land and Water Resources

Southport Mall

P.O. Box 10631

Jackson, Mississippi 39209

WATER WELL DRILLERS LOG

<i>PIKE</i>
<i>K</i>
<i>2052</i>

Jan 24 19*83* *Reener Well Driller Pike*
 date well completed firm name county well located

LANDOWNER:
Mornie Chisler
At Magnolia
 (mailing address)

WELL LOCATION:
 sec. *3* T-*1* N R-*2* E
1 miles *south* of *Chataway*
 (distance) (direction) (nearest town)

WELL PURPOSE: *home*
 (home, irrigation, municipal, industrial)

WELL COMPLETION DATA:

(1) diameter (inches) *4"*

(2) total depth (feet) *111'*

(3) static water level (feet) *75'* below above top of ground.

(4) casing *plastic bottom*
 (material) (depth)

— if telescope see back.
 (size)

(5) screen *5'* *106'*
 (length) (depth to top)

4" *plastic*
 (size) (material)

(6) pump *by other's*
 (HP) (yield gpm)

elect
 (type power)

(7) electric log *no*
 (yes or no)

—
 (organization running log)

description of formations encountered	from	to
<i>Clay</i>	<i>0</i>	<i>17</i>
<i>Red sand</i>	<i>17</i>	<i>60</i>
<i>Sand & gravel</i>	<i>60</i>	<i>80</i>
<i>Chalk & gravel</i>	<i>80</i>	<i>100</i>
<i>Coarse sand & gravel</i>	<i>100</i>	<i>111</i>

(8) how well bottom plugged *back wash*

DRILLERS REMARKS:


DEPT. OF NATURAL RESOURCES
 BUREAU OF LAND & WATER RESOURCES

APR 27 1983

RECEIVED

If well telescopes please sketch and show depths.

GROUND LEVEL

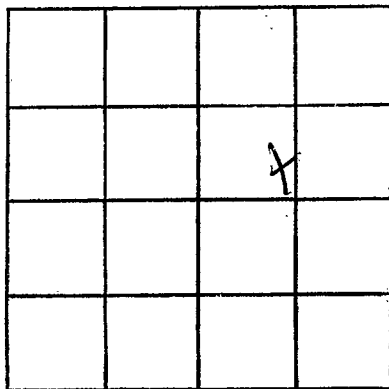

SECTION 3

Please indicate well location X.

ADDITIONAL INFORMATION

If more than one screen,
show locations of each on sketch.