

PIKE  
K  
2084

MISSISSIPPI  
BOARD OF WATER COMMISSIONERS  
416 North State Street  
Jackson, Mississippi 39201

WATER WELL DRILLERS LOG

7-21 1983 Fitzgerald Well Serv Pike  
date well completed firm name county well located

LANDOWNER:	description of formations encountered	from	to
<u>Candy Taylor</u>			
<u>RR- Chatawa ms.</u> (mailing address)	<u>Red clay</u> <u>white chalk</u> <u>Coarse sand &amp; gravel</u>	<u>0</u> <u>20</u> <u>105</u>	<u>20</u> <u>105</u> <u>120</u>
<b>WELL LOCATION:</b>			
sec. <u>24</u> T <u>1</u> N R <u>7</u> E S W			
<u>2</u> miles <u>S</u> of <u>Chatawa</u> (distance) (direction) (nearest town)			
<b>WELL PURPOSE:</b> <u>Home</u> (home, irrigation, municipal, industrial)			
<b>WELL COMPLETION DATA:</b>			
(1) diameter (inches) <u>4</u>			
(2) total depth (feet) <u>120</u>			
(3) static water level (feet) <u>50</u> below top of ground. above			
(4) casing <u>PVC</u> , <u>112</u> , (material) (depth)			
<u>4</u> (size) if telescope see back.			
(5) screen <u>8</u> , <u>112</u> (length) (depth to top)			
<u>4</u> , <u>PVC</u> (size) (material)			
(6) pump <u>1/2</u> , <u>10</u> (HP) (yield gpm)			
<u>Electric</u> (type power)			
(7) electric log <u>no</u> (yes or no)			
(organization running log)			
(8) how well bottom plugged <u>Seal off</u>			
<b>DRILLERS REMARKS:</b>			


DEPT. OF NATURAL RESOURCES  
BUREAU OF LAND & WATER RESOURCES

AUG 15 1983

RECEIVED

If well telescopes please sketch and show depths.

GROUND LEVEL

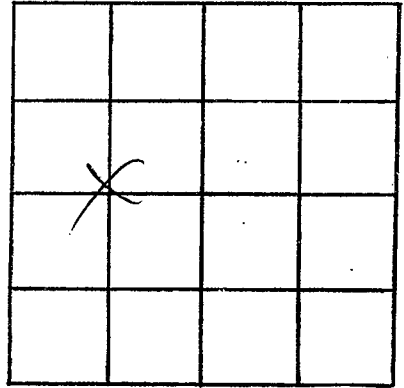

SECTION 24

Please indicate well location X.

ADDITIONAL INFORMATION

If more than one screen,  
show locations of each on sketch.