

MISSISSIPPI DEPARTMENT OF NATURAL RESOURCES

Bureau of Land and Water Resources

Southport Mall

P.O. Box 10631

Jackson, Mississippi 39209

WATER WELL DRILLERS LOG

PIKE
K
2055

May 29 1983 Pearson Pike
date well completed firm name county well located

LANDOWNER:
Jackie Speed
At Osyka
(mailing address)

description of formations encountered	from	to
<u>Red Clay</u>	<u>0</u>	<u>20</u>
<u>Red sand</u>	<u>20</u>	<u>60</u>
<u>rough sand clay</u>	<u>60</u>	<u>110</u>
<u>Chipse and</u>	<u>110</u>	<u>120</u>

WELL LOCATION:
sec. 15 T. 1 N R. 7 E
3 1/2 miles N of Oryka
(distance) (direction) (nearest town)

WELL PURPOSE: house
(home, irrigation, municipal, industrial)

- WELL COMPLETION DATA:
- (1) diameter (inches) 4"
 - (2) total depth (feet) 120'
 - (3) static water level (feet) 60' below above top of ground.
 - (4) casing plastic, pvc (material) 120' (depth)
 - (size) if telescope see back.
 - (5) screen 5" (length) 115' (depth to top)
 - 4" (size) plastic (material)
 - (6) pump 1/2 HP (HP) — (yield gpm)
 - electric (type power)
 - (7) electric log no (yes or no)
 - (organization running log)

(8) how well bottom plugged back wash

DRILLERS REMARKS:
—


DEPT. OF NATURAL RESOURCES
BUREAU OF LAND & WATER RESOURCES

SEP 28 1983

RECEIVED

If well telescopes please sketch and show depths.

GROUND LEVEL

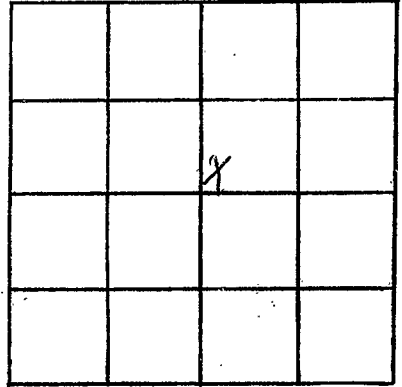

SECTION 15

Please indicate well location X.

ADDITIONAL INFORMATION

If more than one screen,
show locations of each on sketch.