

MISSISSIPPI DEPARTMENT OF NATURAL RESOURCES

Bureau of Land and Water Resources

Southport Mall

P.O. Box 10631

Jackson, Mississippi 39209

WATER WELL DRILLERS LOG

PIKE
K
2056

June 4 1983 Pikes Mill Sec Pike
date well completed firm name county well located

LANDOWNER: James Maffitt

description of formations encountered from to

Chatahuc
(mailing address)

Sand 0 30
White Chalk 30 98
Hard Sand Rock 98 100
fine sand 100 155
hard rock 155 160
white clay clay 160 195

WELL LOCATION:
sec. 2 T 1 N R 7 E
5 miles S of Magnolia
(distance) (direction) (nearest town)

fine sand 195 215
Red gravel sand 215 233

WELL PURPOSE: Drain
(home, irrigation, municipal, industrial)

WELL COMPLETION DATA:

(1) diameter (inches) 4"

(2) total depth (feet) 233

(3) static water level (feet) below
top of ground.

(4) casing plastic bottom
(material) (depth)

7 if telescope see back.
(size)

(5) screen 10', 223'
(length) (depth to top)

4", plastic
(size) (material)

(6) pump Flow 25
(HP) (yield gpm)

(type power)

(7) electric log no
(yes or no)

(organization running log)

(8) How well bottom plugged
rock hard

DRILLERS REMARKS:
none


DEPT. OF NATURAL RESOURCES
BUREAU OF LAND & WATER RESOURCES

SEP 28 1983

RECEIVED

If well telescopes please sketch and show depths.

GROUND LEVEL

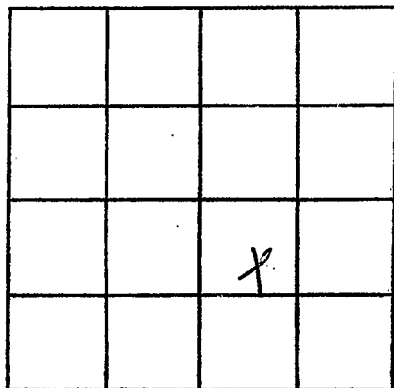

SECTION 2

Please indicate well location X.

ADDITIONAL INFORMATION

If more than one screen,
show locations of each on sketch.