

MISSISSIPPI DEPARTMENT OF NATURAL RESOURCES

Bureau of Land and Water Resources

Southport Mall

P.O. Box 10631

Jackson, Mississippi 39209

WATER WELL DRILLERS LOG

PIKE
K
2057

June 8 1983 Sumnerville Pike
date well completed firm name county well located

LANDOWNER:	description of formations encountered	from	to
Beachwood Bluff Cattaraugus (mailing address)			
WELL LOCATION:			
sec. 2 T-1 N R-7 E 5 miles South of Mag. (distance) (direction) (nearest town)			
WELL PURPOSE: <u>Camp</u> (home, irrigation, municipal, industrial)			
WELL COMPLETION DATA:			
(1) diameter (inches) <u>4"</u>			
(2) total depth (feet) <u>96</u>			
(3) static water level (feet) <u>72</u> below above top of ground.			
(4) casing <u>Plastic, 1/2" pattern</u> (material) (depth)			
(size) if telescope see back.			
(5) screen <u>5' 91'</u> (length) (depth to top)			
<u>4"</u> <u>Plastic</u> (size) (material)			
(6) pump <u>2 sub 10</u> (HP) (yield gpm)			
<u>Unit</u> (type power)			
(7) electric log <u>no</u> (yes or no)			
(organization running log)			
(8) how well bottom plugged <u>Rock wash</u>			
DRILLERS REMARKS: <u>Bad Rocks!</u>			


DEPT. OF NATURAL RESOURCES
BUREAU OF LAND & WATER RESOURCES

SEP 28 1983

RECEIVED

If well telescopes please sketch and show depths.

GROUND LEVEL

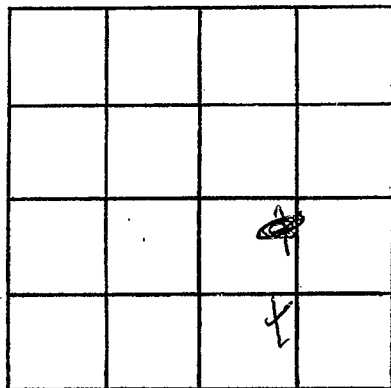

SECTION 2

Please indicate well location X.

ADDITIONAL INFORMATION

If more than one screen,
show locations of each on sketch.