

MISSISSIPPI DEPARTMENT OF NATURAL RESOURCES

Bureau of Land and Water Resources

Southport Mall

P.O. Box 10631

Jackson, Mississippi 39209

WATER WELL DRILLERS LOG

Pike
K
2089

2-14

1984

Frederick L. Pike

Pike

date well completed

firm name

county well located

LANDOWNER:

Steve Obernethy

description of formations encountered

from

to

P.R. Magniters.
(mailing address)

Red clay
Red sand & sand banks -
Coarse sand & gravel

0 20
20 90
90 100

WELL LOCATION:

sec. 11 T. 1 N. R. 7 E
S W
1 miles N of CHAATAWA
(distance) (direction) (nearest town)

WELL PURPOSE:

Home
(home, irrigation, municipal, industrial)

WELL COMPLETION DATA:

- (1) diameter (inches) 4
- (2) total depth (feet) 100
- (3) static water level (feet) 70 below above top of ground.
- (4) casing MC 92
(material) (depth)
4 if telescope see back.
(size)
- (5) screen 8 92
(length) (depth to top)
4 MC
(size) (material)
- (6) pump 1 1/2 10
(HP) (yield gpm)
ala
(type power)
- (7) electric log no
(yes or no)
(organization running log)
- (8) how well bottom plugged Sand fill

DEPT. OF NATURAL RESOURCES
BUREAU OF LAND & WATER RESOURCES


MAR -7 1984

RECEIVED

DRILLERS REMARKS:

If well telescopes please sketch and show depths.

GROUND LEVEL

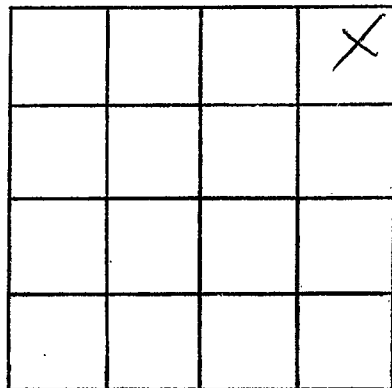

SECTION 11

Please indicate well location X.

ADDITIONAL INFORMATION

If more than one screen,
show locations of each on sketch.