

MISSISSIPPI DEPARTMENT OF NATURAL RESOURCES

Bureau of Land and Water Resources

Southport Mall

P.O. Box 10631

Jackson, Mississippi 39209

WATER WELL DRILLERS LOG

PIKE
K
2060

8-15
date well completed

1984 Fitzgerald Well Serv
firm name

Pike
county well located

LANDOWNER:

Jimmy Williams

R.B. Osyka, ms.
(mailing address)

description of formations encountered

from to

<u>Red Clay</u>	<u>0</u>	<u>20</u>
<u>Red siltstone clay</u>	<u>20</u>	<u>140</u>
<u>Coarse sandstone</u>	<u>140</u>	<u>155</u>

WELL LOCATION:

sec. 16 T 1 N R 2 E
S W
4 miles WNW of OSYRA
(distance) (direction) (nearest town)

WELL PURPOSE:

home
(home, irrigation, municipal, industrial)

WELL COMPLETION DATA:

- (1) diameter (inches) 4
- (2) total depth (feet) 155
- (3) static water level (feet) 30 below above top of ground.
- (4) casing PVC (material), 147 (depth),
4 (size) if telescope see back.
- (5) screen 8 (length), 147 (depth to top),
4 (size), PVC (material)
- (6) pump 1/2 (HP), 10 (yield gpm),
Elc (type power)
- (7) electric log no (yes or no)
(organization running log)
- (8) how well bottom plugged Seal

DRILLERS REMARKS:


DEPT. OF NATURAL RESOURCES
BUREAU OF LAND & WATER RESOURCES

AUG 23 1984

RECEIVED

If well telescopes please
sketch and show depths.

GROUND LEVEL

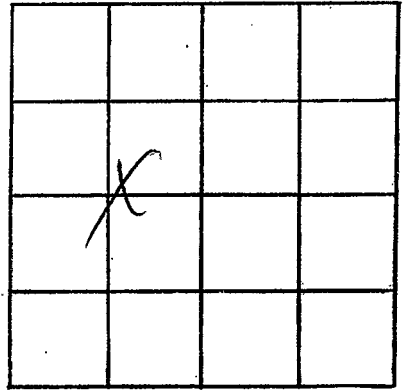

SECTION 16

Please indicate well location X.

ADDITIONAL INFORMATION

If more than one screen,
show locations of each on sketch.