

MISSISSIPPI DEPARTMENT OF NATURAL RESOURCES

Bureau of Land and Water Resources

Southport Mall

P.O. Box 10631

Jackson, Mississippi 39209

WATER WELL DRILLERS LOG

K 2003
PIKE
4-7-85

4-7 1985
date well completed

F. G. ... well service Pike
firm name county well located

LANDOWNER:	description of formations encountered	from	to
Wiley Williamson P.O. Box Chataway, Miss. (mailing address)			
WELL LOCATION:			
sec. 11 T. 10 N. R. 2 E 6 miles S of Magnolia (distance) (direction) (nearest town)			
WELL PURPOSE: Home (home, irrigation, municipal, industrial)			
WELL COMPLETION DATA:			
(1) diameter (inches) 4			
(2) total depth (feet) 105			
(3) static water level (feet) 75 below top of ground			
(4) casing PVC, 95 (material) (depth) 4 (size) if telescope see back.			
(5) screen 10, 95 (length) (depth to top) 4 (size) PVC (material)			
(6) pump 1/2 (HP) 10 (yield gpm) Elec (type power)			
(7) electric log no (yes or no) (organization running log)			
(8) how well bottom plugged Seal block			


RECEIVED
APR 10 1985

Department of Natural Resources
Bureau of Land & Water Resources

DRILLERS REMARKS:

If well telescopes please sketch and show depths.

GROUND LEVEL

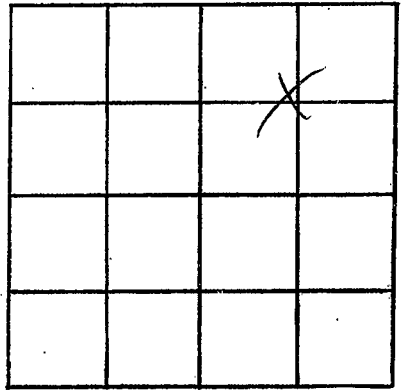

SECTION 11

Please indicate well location X.

ADDITIONAL INFORMATION

If more than one screen,
show locations of each on sketch.