

MISSISSIPPI DEPARTMENT OF NATURAL RESOURCES

Bureau of Land and Water Resources

Southport Mall

P.O. Box 10631

Jackson, Mississippi 39209

WATER WELL DRILLERS LOG

Pike
K road
6-18-85

6-18 1985
date well completed

firm name

county well located

LANDOWNER:	description of formations encountered	from	to
<p>Jerry Joe Rayburn P.O. Dryden, Ms. (mailing address)</p>	<p>Red clay Red gravel White & blue chalk Coarse sand & gravel</p>	<p>0 20 35 160</p>	<p>20 35 160 176</p>
<p>WELL LOCATION: sec. <u>35</u> T <u>1</u> N R <u>7</u> E S W <u>1</u> miles <u>E</u> of <u>OSYKA</u> (distance) (direction) (nearest town)</p>			
<p>WELL PURPOSE: <u>Home</u> (home, irrigation, municipal, industrial)</p>			
<p>WELL COMPLETION DATA:</p> <p>(1) diameter (inches) <u>4</u></p> <p>(2) total depth (feet) <u>176</u></p> <p>(3) static water level (feet) <u>6</u> below above top of ground.</p> <p>(4) casing <u>PVC</u> <u>166</u> (material) (depth) <u>4</u> (size) if telescope see back.</p> <p>(5) screen <u>10</u> <u>166</u> (length) (depth to top) <u>4</u> <u>PVC</u> (size) (material)</p> <p>(6) pump <u>1/2</u> <u>10</u> (HP) (yield gpm) <u>Ela</u> (type power)</p> <p>(7) electric log <u>no</u> (yes or no) <u>(organization running log)</u></p> <p>(8) how well bottom plugged <u>Sand fill</u></p>			

DRILLERS REMARKS:

RECEIVED


JUL 22 1985

Department of Natural Resources
Bureau of Land & Water Resources

If well telescopes please sketch and show depths.

10

GROUND LEVEL

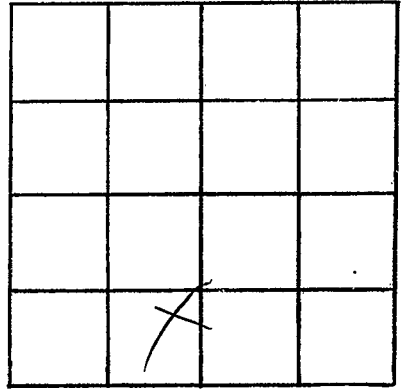

SECTION 25

Please indicate well location X.

ADDITIONAL INFORMATION

If more than one screen,
show locations of each on sketch.