

MISSISSIPPI DEPARTMENT OF NATURAL RESOURCES

Bureau of Land and Water Resources

Southport Mall

P.O. Box 10631

Jackson, Mississippi 39209

WATER WELL DRILLERS LOG

Pike  
K 2005  
7-9-85

L

7-9 1985 Fitzgerald Sewer Pike  
date well completed firm name county well located


LANDOWNER:	description of formations encountered	from	to
<u>William Lewis</u> <u>R.R. Oyster, ms.</u> (mailing address)			
WELL LOCATION: sec. <u>22</u> T <u>1</u> N R <u>7</u> E S <u>3</u> miles <u>WNW</u> of <u>Oyster</u> (distance) (direction) (nearest town)			
WELL PURPOSE: <u>Home</u> (home, irrigation, municipal, industrial)			
WELL COMPLETION DATA:			
(1) diameter (inches) <u>4</u>			
(2) total depth (feet) <u>110</u>			
(3) static water level (feet) <u>85</u> below above top of ground.			
(4) casing <u>PVC</u> <u>100</u> (material) (depth) <u>4</u> if telescope see back. (size)			
(5) screen <u>10</u> <u>100</u> (length) (depth to top) <u>4</u> <u>PVC</u> (size) (material)			
(6) pump <u>1/2</u> <u>10</u> (HP) (yield gpm) <u>Electric</u> (type power)			
(7) electric log <u>No</u> (yes or no) <u>(organization running log)</u>			
(8) how well bottom plugged <u>Sand Seal</u>			

RECEIVED  
JUL 25 1985

DRILLERS REMARKS:  
Department of Natural Resources  
Bureau of Land & Water Resources

If well telescopes please sketch and show depths.

GROUND LEVEL

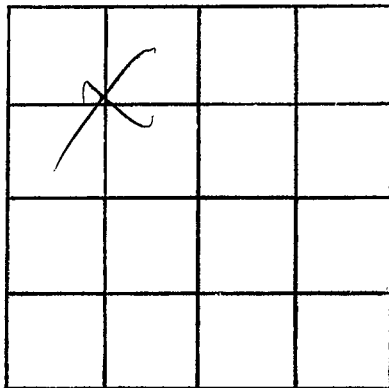

SECTION 22

Please indicate well location X.

ADDITIONAL INFORMATION

If more than one screen,  
show locations of each on sketch.