

MISSISSIPPI DEPARTMENT OF NATURAL RESOURCES

Bureau of Land and Water Resources

Southport Mall

P.O. Box 10631

Jackson, Mississippi 39209

WATER WELL DRILLERS LOG

PIKE  
K  
2069

7-22 1985 Fitzgerald Well Drilling Pike  
date well completed firm name county well located

LANDOWNER:  
Willton Biggs  
Osyka, ms.  
(mailing address)

description of formations encountered	from	to
<u>Red clay</u>	<u>0</u>	<u>15</u>
<u>Red gravel</u>	<u>15</u>	<u>48</u>
<u>white &amp; blue chert</u>	<u>48</u>	<u>195</u>
<u>Coarse sand &amp; gravel</u>	<u>195</u>	<u>210</u>

WELL LOCATION:  
sec. 35 T 1 N R 7 E  
S W  
1N miles - of OSYKA  
(distance) (direction) (nearest town)

WELL PURPOSE: Home  
(home, irrigation, municipal, industrial)

- WELL COMPLETION DATA:
- (1) diameter (inches) 4
  - (2) total depth (feet) 210
  - (3) static water level (feet) 50 below above top of ground.
  - (4) casing P.C., 200,  
(material) (depth)  
4 if telescope see back.  
(size)
  - (5) screen 10, 200  
(length) (depth to top)  
4, P.C.  
(size) (material)
  - (6) pump 3/4, 15  
(HP) (yield gpm)  
Electric  
(type power)
  - (7) electric log no  
(yes or no)  
(organization running log)
  - (8) how well bottom plugged Small plug

RECEIVED


NOV - 5 1985

Department of Natural Resources  
Bureau of Land & Water Resources

DRILLERS REMARKS:

If well telescopes please sketch and show depths.

GROUND LEVEL

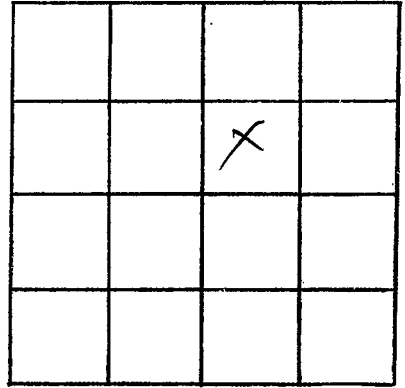

SECTION 35

Please indicate well location X.

ADDITIONAL INFORMATION

If more than one screen,  
show locations of each on sketch.

