

MISSISSIPPI DEPARTMENT OF NATURAL RESOURCES

Bureau of Land and Water Resources

Southport Mall

P.O. Box 10631

Jackson, Mississippi 39209

WATER WELL DRILLERS LOG

PIKE
K
2070

11-19-1985  
date well completed

Ritzman  
firm name

PIKE  
county well located

LANDOWNER:	description of formations encountered	from	to
CAPPY LANZAFAMI			
RR. Oneha mi. (mailing address)	Red clay Red sand gravel, gravel, gravel	0 20 50	20 50 95
WELL LOCATION:			
sec. 34 T 1 N R 7 E S W			
1/4 miles SW of Oryza (distance) (direction) (nearest town)			
WELL PURPOSE: (home, irrigation, municipal, industrial)			
WELL COMPLETION DATA:			
(1) diameter (inches) 4			
(2) total depth (feet) 95			
(3) static water level (feet) 42 below top of ground.			
(4) casing PVC, 85 (material) (depth) 4 (size) if telescope see back.			
(5) screen 10, 85 (length) (depth to top) 4 (size) PVC (material)			
(6) pump 3/4, 15 (HP) (yield gpm) Ela (type power)			
(7) electric log No (yes or no) (organization running log)			
(8) how well bottom plugged Sand shk			
DRILLERS REMARKS:			


RECEIVED

NOV 27 1985

Department of Natural Resources  
Bureau of Land & Water Resources

If well telescopes please sketch and show depths.

GROUND LEVEL

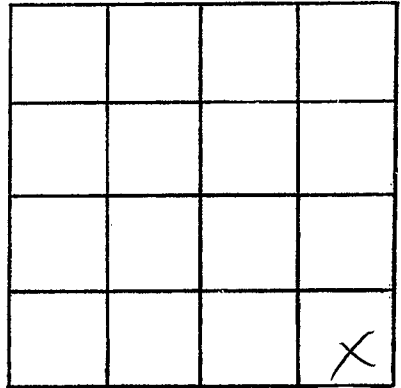

SECTION 34

Please indicate well location X.

ADDITIONAL INFORMATION

If more than one screen,  
show locations of each on sketch.