

MISSISSIPPI DEPARTMENT OF NATURAL RESOURCES

Bureau of Land and Water Resources

Southport Mall

P.O. Box 10631


Jackson, Mississippi 39209

WATER WELL DRILLERS LOG

PIKE
K
2071

4-11-1986 date well completed Stafford Waterwell firm name Pike county well located

<p>LANDOWNER: <u>MRS. OKIA SEAB</u> <u>Rt. 1 Osyka, MS.</u> <u>39657</u> (mailing address)</p>	<table border="1"> <thead> <tr> <th data-bbox="545 331 958 427">description of formations encountered</th> <th data-bbox="958 331 1038 427">from</th> <th data-bbox="1038 331 1122 427">to</th> </tr> </thead> <tbody> <tr> <td data-bbox="545 427 958 486">top soil</td> <td data-bbox="958 427 1038 486">0</td> <td data-bbox="1038 427 1122 486">6"</td> </tr> <tr> <td data-bbox="545 486 958 546">brown clay</td> <td data-bbox="958 486 1038 546">6"</td> <td data-bbox="1038 486 1122 546">21"</td> </tr> <tr> <td data-bbox="545 546 958 606">white & pink clay</td> <td data-bbox="958 546 1038 606">21"</td> <td data-bbox="1038 546 1122 606">43"</td> </tr> <tr> <td data-bbox="545 606 958 666">course sand & gravel</td> <td data-bbox="958 606 1038 666">43"</td> <td data-bbox="1038 606 1122 666">65"</td> </tr> </tbody> </table>	description of formations encountered	from	to	top soil	0	6"	brown clay	6"	21"	white & pink clay	21"	43"	course sand & gravel	43"	65"
description of formations encountered	from	to														
top soil	0	6"														
brown clay	6"	21"														
white & pink clay	21"	43"														
course sand & gravel	43"	65"														
<p>WELL LOCATION: sec. <u>25</u> T. <u>10</u> S. R. <u>7</u> E. W. <u>1</u> <u>11</u> miles (distance) <u>NW</u> (direction) of <u>Osyka</u> (nearest town)</p>																
<p>WELL PURPOSE: <u>none</u> (home, irrigation, municipal, industrial)</p>																
<p>WELL COMPLETION DATA:</p> <p>(1) diameter (inches) <u>4"</u></p> <p>(2) total depth (feet) <u>65</u></p> <p>(3) static water level (feet) <u>46</u> below/above top of ground.</p> <p>(4) casing <u>plastic</u>, <u>65'</u> (material) (depth) (size) if telescope see back.</p> <p>(5) screen <u>10'</u>, <u>5.5'</u> (length) (depth to top) <u>4"</u>, <u>plastic</u> (size) (material)</p> <p>(6) pump <u>1/2</u>, <u>11</u> (HP) (yield gpm) <u>electric</u> (type power)</p> <p>(7) electric log <u> </u> (yes or no) (organization running log)</p> <p>(8) how well bottom plugged <u>sand</u> <u>spark</u></p>																

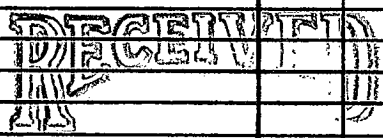


Department of Natural Resources

DRILLERS REMARKS:
Wade Bottom

If well telescopes please sketch and show depths.

GROUND LEVEL

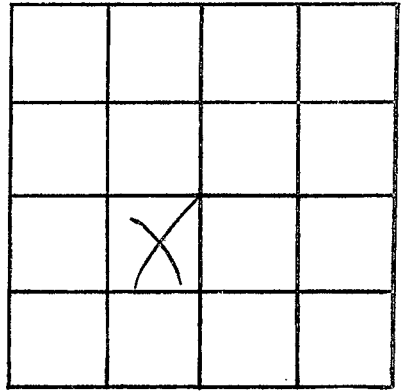

SECTION 25

Please indicate well location X.

ADDITIONAL INFORMATION

If more than one screen,
show locations of each on sketch.