

MISSISSIPPI DEPARTMENT OF NATURAL RESOURCES

Bureau of Land and Water Resources

Southport Mall

P.O. Box 10631

Jackson, Mississippi 39209

WATER WELL DRILLERS LOG


Dike
K
2072

4-17 1986
date well completed

H. G. ...
firm name

Pike
county well located

LANDOWNER:	description of formations encountered	from	to
		<i>Russell Brown</i>	
<i>R.B. Oyster, Jr.</i> (mailing address)	<i>Red clay</i>	<i>0</i>	<i>20</i>
	<i>Red sand</i>	<i>20</i>	<i>85</i>
	<i>Coarse sand & gravel</i>	<i>85</i>	<i>111</i>
WELL LOCATION:			
sec. <i>31</i> T. <i>1</i> N. R. <i>7</i> E.			
<i>4</i> miles <i>W</i> of <i>OSYRA</i>			
(distance) (direction) (nearest town)			
WELL PURPOSE:			
<i>Home</i> (home, irrigation, municipal, industrial)			
WELL COMPLETION DATA:			
(1) diameter (inches) <i>4</i>			
(2) total depth (feet) <i>111</i>			
(3) static water level (feet) <i>55</i> below top of ground.			
(4) casing <i>PVC 91</i> (material) (depth)			
<i>4</i> if telescope see back. (size)			
(5) screen <i>20 91</i> (length) (depth to top)			
<i>4 PVC</i> (size) (material)			
(6) pump <i>1 25</i> (HP) (yield gpm)			
<i>Elec</i> (type power)			
(7) electric log <i>No</i> (yes or no)			
<i>Sand</i> (organization running log)			
(8) how well bottom plugged <i>Sand</i>			

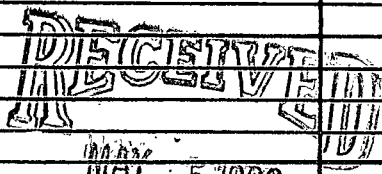

MAY 5 1986

DRILLERS REMARKS:

Department of Natural Resources
Bureau of Land & Water Resources

If well telescopes please sketch and show depths.

GROUND LEVEL

X			

SECTION 31

Please indicate well location X.

ADDITIONAL INFORMATION

If more than one screen,
show locations of each on sketch.