

MISSISSIPPI DEPARTMENT OF NATURAL RESOURCES

Bureau of Land and Water Resources

Southport Mall

P.O. Box 10631

Jackson, Mississippi 39209

WATER WELL DRILLERS LOG

PIKE
R
2073

5-2 1986 Fitzgerald well Sec Pike  
 date well completed firm name county well located


LANDOWNER:	description of formations encountered	from	to
<u>Randy Stieckland</u>			
<u>B.B. Ogden, ms.</u> (mailing address)	<u>Red clay</u>	<u>0</u>	<u>20</u>
	<u>white clay</u>	<u>20</u>	<u>80</u>
	<u>Coarse sand &amp; gravel</u>	<u>80</u>	<u>93</u>
WELL LOCATION:			
sec. <u>26</u> T <u>1</u> N R <u>7</u> E S W			
<u>1</u> miles <u>N</u> of <u>OSYRA</u> (distance) (direction) (nearest town)			
WELL PURPOSE: <u>Home</u> (home, irrigation, municipal, industrial)			
WELL COMPLETION DATA:			
(1) diameter (inches) <u>4</u>			
(2) total depth (feet) <u>93</u>			
(3) static water level (feet) <u>70</u> below above top of ground.			
(4) casing <u>MC</u> , <u>83</u> (material) (depth)			
<u>4</u> (size) if telescope see back.			
(5) screen <u>10</u> , <u>83</u> (length) (depth to top)			
<u>4</u> , <u>MC</u> (size) (material)			
(6) pump <u>1/2</u> , <u>10</u> (HP) (yield gpm)			
<u>Elux</u> (type power)			
(7) electric log <u>No</u> (yes or no)			
<u></u> (organization running log)			
(8) how well bottom plugged <u>Sealed</u>			

RECEIVED  
 MAY 28 1986  
 MISSISSIPPI DEPARTMENT OF NATURAL RESOURCES

DRILLERS REMARKS:

If well telescopes please sketch and show depths.

GROUND LEVEL

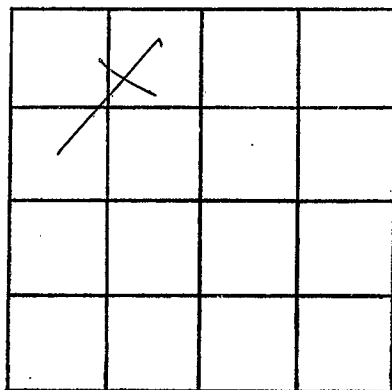

SECTION 26

Please indicate well location X.

ADDITIONAL INFORMATION

If more than one screen,  
show locations of each on sketch.