

PIKE
K 2078

MISSISSIPPI DEPARTMENT OF NATURAL RESOURCES
Bureau of Land and Water Resources
Southport Mall
P.O. Box 10631
Jackson, Mississippi 39209
WATER WELL DRILLERS LOG

8-24 1987 Fitzgibbon Dr Pike
date well completed firm name county well located

LANDOWNER:
Frank Foster
R.R. Magnolia Dr.
(mailing address)

WELL LOCATION:
sec. 10 T. 1 N R. 7 E
S W
14 miles CHATAWA
(distance) (direction) of (nearest town)

WELL PURPOSE: Home
(home, irrigation, municipal, industrial)


- WELL COMPLETION DATA:
- (1) diameter (inches) 4
 - (2) total depth (feet) 181
 - (3) static water level (feet) 68 below above top of ground.
 - (4) casing 10 171
(material) (depth)
4 if telescope see back.
(size)
 - (5) screen 10 171
(length) (depth to top)
4 10
(size) (material)
 - (6) pump 3/4 15
(HP) (yield gpm)
Electric
(type power)
 - (7) electric log No
(yes or no)
(organization running log)
 - (8) how well bottom plugged Sealed

description of formations encountered	from	to
<u>Red clay</u>	<u>0</u>	<u>20</u>
<u>Red sand</u>	<u>20</u>	<u>60</u>
<u>White Blue chalk</u>	<u>60</u>	<u>165</u>
<u>Green sand & gravel</u>	<u>165</u>	<u>181</u>
RECEIVED		
AUG 27 1987		
Department of Natural Resources Bureau of Land & Water Resources		

DRILLERS REMARKS:

If well telescopes please sketch and show depths.

GROUND LEVEL

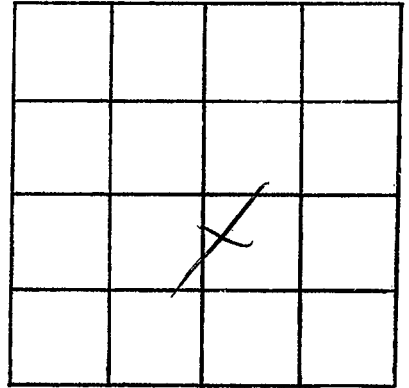

SECTION 10

Please indicate well location X.

ADDITIONAL INFORMATION

If more than one screen,
show locations of each on sketch.