

PIKE  
K  
2020

MISSISSIPPI DEPARTMENT OF NATURAL RESOURCES  
Bureau of Land and Water Resources  
Southport Mall  
P.O. Box 10631  
Jackson, Mississippi 39209  
WATER WELL DRILLERS LOG

6-11 1990 F. Smallwell Inc Pike  
date well completed firm name county well located

LANDOWNER:	description of formations encountered	from	to
		<u>Myrtle Marshall</u>	
<u>Rt. 1, Osyka, ms.</u> (mailing address)	<u>Red clay</u>	<u>0</u>	<u>20</u>
	<u>Red sand</u>	<u>20</u>	<u>122</u>
	<u>Coarse sand &amp; gravel</u>	<u>122</u>	<u>135</u>

WELL LOCATION:  
sec. 31 T 1 N R 7 E  
S W  
3 miles W of Osyka  
(distance) (direction) (nearest town)

WELL PURPOSE: Home  
(home, irrigation, municipal, industrial)

- WELL COMPLETION DATA:
- (1) diameter (inches) 4
  - (2) total depth (feet) 135
  - (3) static water level (feet) 68 below above top of ground.
  - (4) casing PVC, 125  
(material) (depth)  
4 if telescope see back.  
(size)
  - (5) screen 10, 125  
(length) (depth to top)  
4, PVC  
(size) (material)
  - (6) pump 1/2, 10  
(HP) (yield gpm)  
Elec  
(type power)
  - (7) electric log no  
(yes or no)  
(organization running log)
  - (8) how well bottom plugged Small


RECEIVED  
JUN 28 1991

Department of Natural Resources  
Bureau of Land & Water Resources

DRILLERS REMARKS:

If well telescopes please sketch and show depths.

GROUND LEVEL

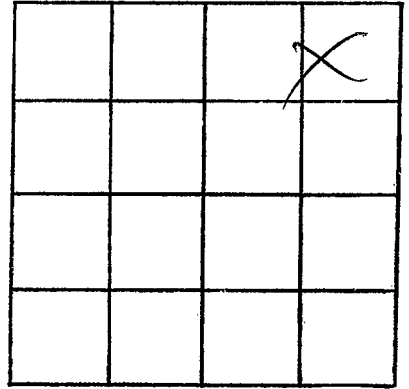

SECTION 31

Please indicate well location X.

ADDITIONAL INFORMATION

If more than one screen,  
show locations of each on sketch.