

MISSISSIPPI DEPARTMENT OF ENVIRONMENTAL QUALITY
Bureau of Land and Water Resources

P. O. Box 10631
Jackson, MS 39289-0631
WATER WELL DRILLERS LOG

COUNTY WELL LOCATED Pike	
WELL NUMBER Lea # 2	CODED
K 2093	
DATE WELL COMPLETED 5/27/92	

PERMIT NUMBER 453
NAME OF DRILLING FIRM Morphis Brothers
Trout, La 71371

NAME & MAILING ADDRESS OF LANDOWNER Armond R. Lea		
Rt 2 Box 208 A		
Osyka, Miss 39657		
WELL LOCATION:	SEC	TOWNSHIP RANGE
	9	1 N 7 E S W
DISTANCE	DIRECTION	NEAREST TOWN
10 Miles	S	McComb
OTHER LANDMARK Chatawa Exit		
WELL PURPOSE: Home, Irrigation, Municipal, Industrial, Fish Pond, etc.		

PUMP DATA		
PUMP TYPE (Circle One): Submersible, Turbine, Jet, Flowing Well, Other (Describe) _____		
POWER TYPE (Circle One): Electric, Tractor, Diesel, Gasoline, Butane, Other (Describe) _____ H/P _____		
Pump Capacity (GPM)	No. of Stages	Setting Depth FT.
PUMP TEST		
Well yielded 75 GPM with a drawdown of N/A ft. after _____ hours of pumping		

WELL DATA		
Well Depth 220	Casing Diameter (In.) 4	Casing Length (Ft.) 200
Type of Casing PVC	Hole Depth 220	Depth to Static Water Level -
TYPE OF COMPLETION: (Circle One or More): <input checked="" type="checkbox"/> Gravel Packed, <input type="checkbox"/> Underreamed, <input type="checkbox"/> Telescoped, <input type="checkbox"/> Natural Development, <input type="checkbox"/> Open Hole, <input type="checkbox"/> Other (Describe) _____		
Top of Lap Pipe or Reduction in Casing FEET IF TELESCOPED OR MORE THAN ONE SCREEN: USE BACK PAGE		

LOG DATA	
TYPE OF LOG RUN (Circle One): Electric, Gamma Ray, Density, Sonic, Neutron, Other (Describe) _____ No Log Run,	
Name of Organization Running Log	

SCREEN DATA		
Diameter - Inches 4	Length - Feet 20	Slot Size - Inches .020
Screen Type PVC		Depth to Bottom - Feet 0

GEOLOGIC DATA (Office Use Only)			
Surface Elev.	Geologic Unit	Unit Thickness	Depth to Top
Subs. SWL	Date	Analysis	Aquifer Test

Driller's Remarks


DESCRIPTION OF FORMATIONS ENCOUNTERED	FROM	TO
Red Clay	0	20
Sand Gravel	20	40
Sand, Gravel Some Clay	40	60
Sand Gravel Clay	60	120
Med Coarse Brown Sand - Small Gravel	120	220
Some Clay strks		

FORMATIONS (Continued)	FROM	TO
RECEIVED		
JUL 20 1992		
Dept. of Environmental Quality		
Bureau of Land & Water Resources		

IF MORE SPACE IS NEEDED, USE BACK

If well telescopes please
sketch and show depths.

GROUND LEVEL

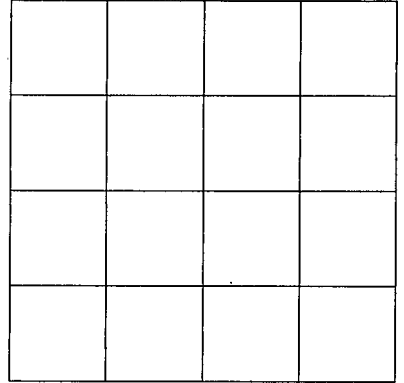

SECTION _____

Please indicate well location X.

ADDITIONAL INFORMATION

If more than one screen,
show location of each on sketch.