

PIKE  
K 2101

MISSISSIPPI  
BOARD OF WATER COMMISSIONERS  
416 North State Street  
Jackson, Mississippi 39201

WATER WELL DRILLERS LOG

march 17 1994 F. T. BERARD Well Services PRK  
date well completed firm name county well located

LANDOWNER:	description of formations encountered	from	to
Bob Wall P.O. Box 2101 (mailing address)	Red Clay Red Sand Coarse Sandstone	0 15 92	15 52 110
WELL LOCATION: sec. 34 T-1 N R-2 E S W 2 miles W of OSIRA (distance) (direction) (nearest town)			
WELL PURPOSE: Home & Business (home, irrigation, municipal, industrial)			
WELL COMPLETION DATA: (1) diameter (inches) 4 (2) total depth (feet) 110 (3) static water level (feet) 50 below top of ground. (4) casing PVC 100 (material), (depth) 4 (size) if telescope see back. (5) screen 10 (length), 100 (depth to top) 4 (size), PVC (material) (6) pump 3/4 (HP), 15 (yield gpm) Eln (type power) (7) electric log No (yes or no) (organization running log) (8) how well bottom plugged Sealed			
DRILLERS REMARKS:			


RECEIVED

JUN 17 1994

Dept. of Environmental Quality  
Office of Land & Water Resources

If well telescopes please sketch and show depths.

GROUND LEVEL

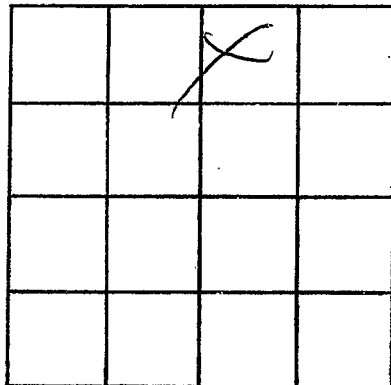

SECTION 34

Please indicate well location X.

ADDITIONAL INFORMATION

Lined area for additional information.

If more than one screen, show locations of each on sketch.