

MISSISSIPPI DEPARTMENT OF ENVIRONMENTAL QUALITY

Office of Land and Water Resources

P. O. Box 10631
Jackson, MS 39289-0631
WATER WELL DRILLERS LOG

COUNTY WELL LOCATED PIKE	
WELL NUMBER K 2123	CODED
DATE WELL COMPLETED 12-1-97	

PERMIT NUMBER 0-287
NAME OF DRILLING FIRM Reeves Well Ser.

NAME & MAILING ADDRESS OF LANDOWNER Harley A Ritter 2097 Terry (Steep Rd)		
WELL LOCATION: SEC 8 TOWNSHIP 1 N RANGE 7 E		
DISTANCE 5 Miles DIRECTION SW of NEAREST TOWN MAGNOLIA		
OTHER LANDMARK		
WELL PURPOSE: Home, Irrigation, Municipal, Industrial, Fish Pond, etc. HOME		

PUMP DATA		
PUMP TYPE (Circle One): Submersible, Turbine, Jet, Flowing Well, Other (Describe) _____		
POWER TYPE (Circle One): Electric, Tractor, Diesel, Gasoline, Butane, Other (Describe) _____ H/P _____		
Pump Capacity (GPM)	No. of Stages	Setting Depth
		FT.
PUMP TEST		
Well yielded	50	GPM with
a drawdown of	0	ft.
after	1	hours of pumping

WELL DATA		
Well Depth 100'	Casing Diameter (In.) 4"	Casing Length (Ft.) 20'
Type of Casing PVC	Hole Depth 100'	Depth to Static Water Level 60'
TYPE OF COMPLETION: (Circle One or More): Gravel Packed, Underreamed, Telescoped, Natural Development, Open Hole, Other (Describe) 10 gal sand		
WELL GROUTED TO A DEPTH OF 1.0 FEET Type Grout (circle one): Cement , Bentonite, or Mix		

LOG DATA	
TYPE OF LOG RUN (Circle One): Electric, Gamma Ray, Density, Sonic, Neutron, Other (Describe) _____	
Name of Organization Running Log	

SCREEN DATA		
Diameter - Inches 4"	Length - Feet 10'	Slot Size - Inches 10 THDS.
Screen Type PVC	Depth to Bottom - Feet 100'	


GEOLOGIC DATA (Office Use Only)			
Surface Elev.	Geologic Unit	Unit Thickness	Depth to Top
Subs. SWL	Date	Analysis	Aquifer Test
Driller's Remarks			
Top of Lap Pipe or Reduction in Casing			
FEET		IF TELESCOPED OR MORE THAN ONE SCREEN: USE BACK PAGE	

DESCRIPTION OF FORMATIONS ENCOUNTERED	FROM	TO	FORMATIONS (continued)	FROM	TO
clay	0	5	06-23-98 FORMATIONS (continued) RCVD		
red sand	5	20			
sand + gravel	20	70			
lumpy sand	70	80			
sand	80	100	06-23-98 09:36 OUT		

IF MORE SPACE IS NEEDED, USE BACK

If well telescopes please
sketch and show depths.

GROUND LEVEL

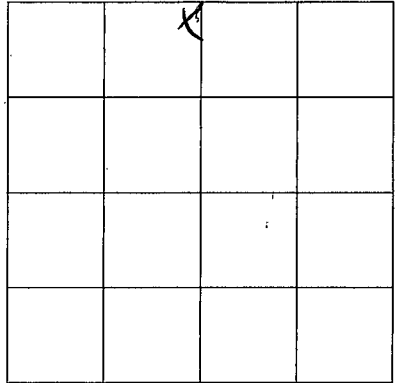

SECTION 8

Please indicate well location X.

ADDITIONAL INFORMATION

If more than one screen,
show location of each on sketch.