

MISSISSIPPI DEPARTMENT OF ENVIRONMENTAL QUALITY

Office of Land and Water Resources

P. O. Box 10631  
Jackson, MS 39289-0631  
WATER WELL DRILLERS LOG

COUNTY WELL LOCATED  
*Pike*

WELL NUMBER  
*R2135* CODED

DATE WELL COMPLETED  
*5-19-99*

PERMIT NUMBER

NAME OF DRILLING FIRM  
*F. Fitzgerald Well Service*

NAME & MAILING ADDRESS OF LANDOWNER  
*Jody Deblanc*  
*First Rd west Aspton*

WELL LOCATION: SEC *18* TOWNSHIP *1* RANGE *7*  
*S* *W*

DISTANCE *4* Miles *West* DIRECTION of *Aspton* NEAREST TOWN

OTHER LANDMARK

WELL PURPOSE:  Home,  Irrigation,  Municipal,  Industrial,  Fish Pond, etc.

PUMP DATA

PUMP TYPE (Circle One):  
Submersible, Turbine, Jet, Flowing Well,  
Other (Describe) \_\_\_\_\_

POWER TYPE (Circle One):  
Electric, Tractor, Diesel, Gasoline, Butane,  
Other (Describe) \_\_\_\_\_ H/P \_\_\_\_\_

Pump Capacity (GPM) No. of Stages Setting Depth  
\_\_\_\_\_ FT.

PUMP TEST

Well yielded \_\_\_\_\_ GPM with  
a drawdown of \_\_\_\_\_ ft.  
after \_\_\_\_\_ hours of pumping

WELL DATA

Well Depth <i>120</i>	Casing Diameter (In.) <i>4"</i>	Casing Length (Ft.) <i>100'</i>
Type of Casing <i>PVC</i>	Hole Depth <i>120'</i>	Depth to Static Water Level <i>63'</i>

TYPE OF COMPLETION: (Circle One or More):  
 Gravel Packed,  Underreamed,  Telescoped,  
 Natural Development,  Open Hole,  Other

WELL GROUTED TO A DEPTH OF *10* FEET  
Type Grout (circle one): Cement, Bentonite, or  Mix

LOG DATA

TYPE OF LOG RUN (Circle One):  
Electric, Gamma Ray, Density, Sonic,  No Log Run, Neutron,  
Other (Describe) \_\_\_\_\_

Name of Organization Running Log  
*Log*

SCREEN DATA

Diameter - Inches <i>40</i>	Length - Feet <i>20</i>	Slot Size - Inches <i>.010/.012</i>
Screen Type <i>PVC</i>	Depth to Bottom - Feet <i>120'</i>	

GEOLOGIC DATA (Office Use Only)

Surface Elev.	Geologic Unit	Unit Thickness	Depth to Top
Subs. SWL	Date	Analysis	Aquifer Test.

Driller's Remarks


Top of Lap Pipe or Reduction in Casing  
**FEET** IF TELESCOPED OR MORE THAN ONE SCREEN: USE BACK PAGE

DESCRIPTION OF FORMATIONS ENCOUNTERED	FROM	TO	FORMATIONS (Continued)	FROM	TO
<i>Top soil</i>	<i>0</i>	<i>5</i>			
<i>clay</i>	<i>5</i>	<i>30</i>			
<i>Sand &amp; gravel</i>	<i>30</i>	<i>70</i>			
<i>clay</i>	<i>70</i>	<i>90</i>			
<i>sand</i>	<i>90</i>	<i>100</i>			
<i>course sand &amp; gravel</i>	<i>100</i>	<i>120</i>			

IF MORE SPACE IS NEEDED, USE BACK

If well telescopes please sketch and show depths.

GROUND LEVEL

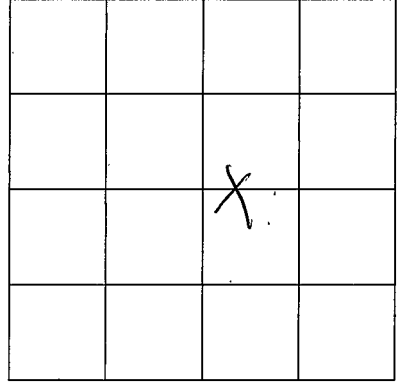

SECTION 18

Please indicate well location X.

ADDITIONAL INFORMATION

A series of horizontal lines for writing additional information, located below the 'ADDITIONAL INFORMATION' header.

If more than one screen,  
show location of each on sketch.