

PIKE ^{CODED}

MISSISSIPPI BOARD OF WATER COMMISSIONERS

L3

3-23-65

WATER WELL DRILLERS LOG

Date: 3-23, 1965, Driller: Chester Reeves County: Pike
(Name)

(1) Owner of Land: Mrs. Mollie Smith
(Name)
RFD 2, McComb
(Address)

(2) Location: 1/4, 1/4, Sec. 22 T. 1 R. 9
4-5 miles SW of Progress
(distance) (direction) (Nearest Town)

(3) Topography: Hilly
(Hilly) (Flat) (Level)

(4) Purpose of Well: Domestic
(Domestic Irrigation
Municipal, Industrial, Other)

Description & Color of Materials Sand, Clay, Red Clay, Shell, etc.	Thick- ness Feet	Depth Feet
Red Surface Clay	20	20
Red sand & gravel	50	70
Red chalk	5	75
Small gravel & sand	12	87

Information upon completion of well:

(1) Diameter 4 inches.

(2) Total Depth 87 feet.

(3) Water Level 75 feet below top of ground.

(4) Cased to Bottom size 4.

(5) Screen: Size 4, Length 7.


(6) Were the formations sealed against pollution?
 _____ yes, no.

If YES depth of formation _____

Why _____

Drillers Remarks:
New House

CODED

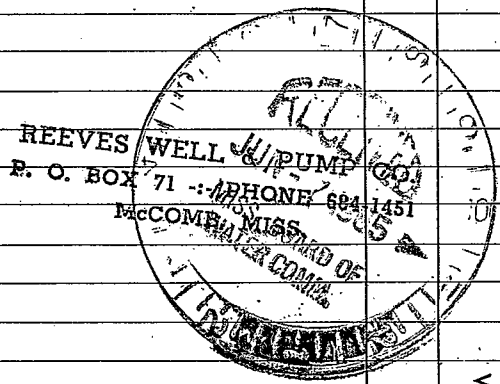

(Use Back Side)

Well No.

1870
The first of the year
was a very cold one
and the snow lay
on the ground for
many days. The
frost was very
severe and the
wind was very
strong. The
people were
very much
concerned
about the
crop. The
government
sent out
a number of
agents to
investigate
the matter.
They found
that the
people were
very poor
and that
the land
was very
barren. The
government
decided to
send out
a number of
agents to
investigate
the matter.
They found
that the
people were
very poor
and that
the land
was very
barren.

The second of the year
was a very warm one
and the snow melted
very early. The
frost was very
light and the
wind was very
gentle. The
people were
very much
pleased
about the
crop. The
government
sent out
a number of
agents to
investigate
the matter.
They found
that the
people were
very poor
and that
the land
was very
barren.

The third of the year
was a very cold one
and the snow lay
on the ground for
many days. The
frost was very
severe and the
wind was very
strong. The
people were
very much
concerned
about the
crop. The
government
sent out
a number of
agents to
investigate
the matter.
They found
that the
people were
very poor
and that
the land
was very
barren.