

Pike **CODED**

L10

3-67

MISSISSIPPI
BOARD OF WATER COMMISSIONERS
416 North State Street
Jackson, Mississippi 39201

WATER WELL DRILLERS LOG

Mar 29 1967 Fitzgould well service Pike
date well completed firm name county well located

LANDOWNER: Conway Huest

description of formations encountered

from to

Progress, Miss. Rt.
(mailing address)

<u>Red clay + sand</u>	<u>6</u>	<u>20</u>
<u>Coarse sand & gravel</u>	<u>20</u>	<u>30</u>
<u>Red chalk</u>	<u>30</u>	<u>40</u>
<u>Red silty sand</u>	<u>40</u>	<u>60</u>
<u>Coarse sand & gravel</u>	<u>60</u>	<u>92</u>

WELL LOCATION:

sec. 12 T. 1 N. R. 8 E.
5 W

12 miles SE of Magnolia
(distance) (direction) (nearest town)

WELL PURPOSE: Home
(home, irrigation, municipal, industrial)

WELL COMPLETION DATA:

- (1) diameter (inches) 4"
- (2) total depth (feet) 98
- (3) static water level (feet) 70 below above top of ground.

(4) casing Plastic, 90'
(material) (depth)

4" if telescope see back.
(size)

(5) screen 8', 90'
(length) (depth to top)

4", Plastic
(size) (material)

(6) pump ? ?
(HP) (yield gpm)

disc
(type power)


(7) electric log No.
(yes or no)

(organization running log)

(8) how well bottom plugged well


DRILLERS REMARKS:

CODED

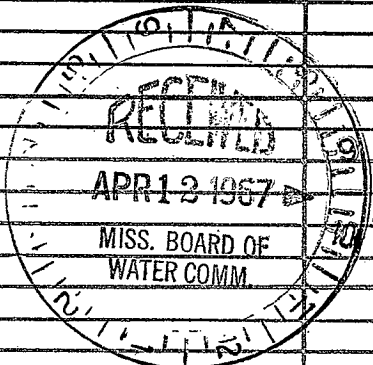

If well telescopes please sketch and show depths.

GROUND LEVEL

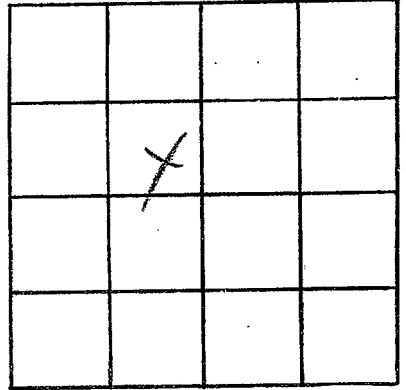

SECTION 12

Please indicate well location X.

ADDITIONAL INFORMATION

If more than one screen, show locations of each on sketch.