

INDEXED

Pike

L12

8-67

MISSISSIPPI
 BOARD OF WATER COMMISSIONERS
 416 North State Street
 Jackson, Mississippi 39201

WATER WELL DRILLERS LOG

date well completed 19 Fitzgerald W. Wood firm name Pike county well located

LANDOWNER

W. S. Jackson

description of formations encountered

from to

Rt 2 McComb Miss

Top soil - clay 0 26
Chalk 26 55
Gravelly sand 55 80
Sand 80 100
Chalk 100 115

(mailing address)

WELL LOCATION:

sec 14 N 8 R 8 E
8 miles SE of Wagnolia
 (distance) (direction) (nearest town)

WELL PURPOSE:

(home, irrigation, municipal, industrial)

WELL COMPLETION DATA:

(1) diameter (inches) 4 1/4

(2) total depth (feet) 114

(3) static water level (feet) _____ below above top of ground.

(4) casing plastic 106
(material) (depth)

4 if telescope see back.
(size)

(5) screen 81 106
(length) (depth to top)

4 plastic 50
(size) (material)

(6) pump 1 1/2 9
(HP) (yield gpm)

Elec
(type power)


(7) electric log No
(yes or no)

(organization running log)

(8) how well bottom plugged Wood Peg


DRILLERS REMARKS:

INDEXED

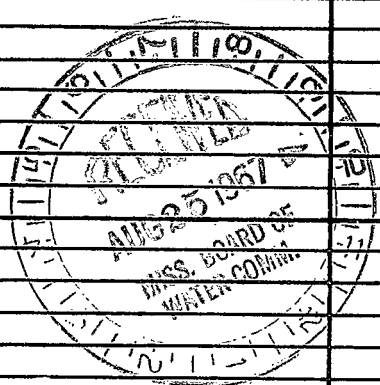

If well telescopes please sketch and show depths.

GROUND LEVEL

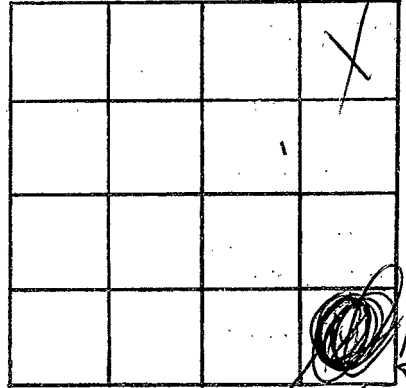

SECTION 14

Please indicate well location X.

ADDITIONAL INFORMATION

If more than one screen, show locations of each on sketch.