

**MISSISSIPPI
BOARD OF WATER COMMISSIONERS**
416 North State Street
Jackson, Mississippi 39201

WATER WELL DRILLERS LOG

Pike CODED
L13
9-67

Sept 25 1967 *Keener Well Drilling Co. Pike*
date well completed firm name county well located

LANDOWNER: *Luther Jones*
RFD Oxya
(mailing address)

description of formations encountered	from	to
<i>sand & gravel</i>	<i>0</i>	<i>15</i>
<i>sandy sand</i>	<i>15</i>	<i>35</i>
<i>white chalk</i>	<i>35</i>	<i>65</i>
<i>fine white sand</i>	<i>65</i>	<i>82</i>

WELL LOCATION:
sec *30* T *1* N R *8* E
2 1/2 miles *E-NE* of *Oxya*
(distance) (direction) (nearest town)

WELL PURPOSE: *drain*
(home, irrigation, municipal, industrial)


WELL COMPLETION DATA:

- (1) diameter (inches) *4"*
- (2) total depth (feet) *82*
- (3) static water level (feet) *49* below top of ground
- (4) casing *plastic, 6' bottom*
(material) (depth)
- _____ if telescope see back.
(size)
- (5) screen *6' 76'*
(length) (depth to top)
- 4"* *plastic*
(size) (material)
- (6) pump *5*
(type) (yield gpm)
- Elect*
(type power)
- (7) electric log *NO*
(yes or no)
- _____ (organization running log)

CODED


(8) how well bottom plugged *wooden plug*

DRILLERS REMARKS: *old well hole*

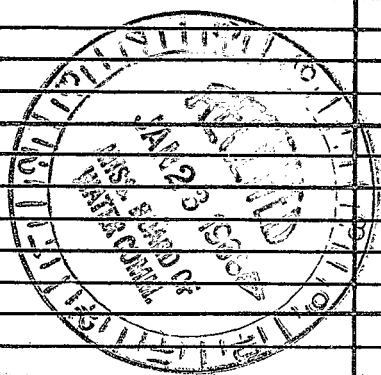

If well telescopes please sketch and show depths.

GROUND LEVEL

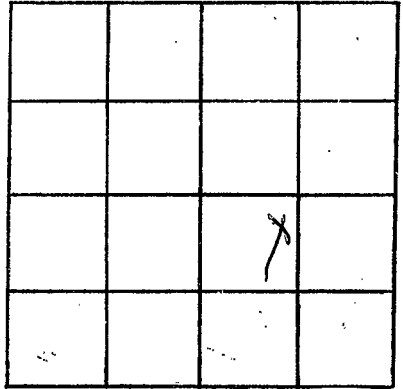

SECTION 30

Please indicate well location X.

ADDITIONAL INFORMATION

If more than one screen,
show locations of each on sketch.