

Pike  
 L14  
 2-68

MISSISSIPPI  
 BOARD OF WATER COMMISSIONERS  
 416 North State Street  
 Jackson, Mississippi 39201

WATER WELL DRILLERS LOG

Feb 5 1968 date well completed  
 Fitzgerald Well Serv firm name  
 Pike county well located

LANDOWNER: Sam Benton

description of formations encountered

RR

Magnolia, Miss.  
 (mailing address)

	from	to
Red clay	0	15
Red sand	15	25
Coarse sand & gravel	25	83

WELL LOCATION:


sec. 5 T 1 N R 8 E  
 4 miles SE of Magnolia  
 (distance) (direction) (nearest town)

WELL PURPOSE:  
 (home, irrigation, municipal, industrial)

WELL COMPLETION DATA:

- (1) diameter (inches) 4
- (2) total depth (feet) 83
- (3) static water level (feet) 67 below top of ground.
- (4) casing Plastic 77' (material) (depth)  
 4" (size) if telescope see back.
- (5) screen 6' 77' (length) (depth to top)  
 4" (size) Plastic (material)
- (6) pump 7 (HP) 7 (yield gpm)  
 Elec (type power)
- (7) electric log No (yes or no)  
 (organization running log)
- (8) how well bottom plugged good for

CODED

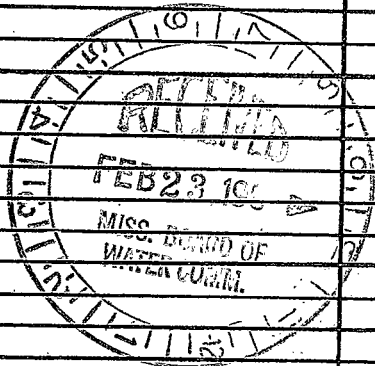

DRILLERS REMARKS:

