

PIKE
 L15
 2-68

MISSISSIPPI
 BOARD OF WATER COMMISSIONERS
 416 North State Street
 Jackson, Mississippi 39201

WATER WELL DRILLERS LOG

Feb 28 1968 *Keeneville Pump Co* PIKE
 date well completed firm name county well located

LANDOWNER: *Donnie Bond*
RFD 1, Osyka
 (mailing address)

description of formations encountered	from	to
<i>yellow clay</i>	<i>0</i>	<i>10</i>
<i>red chert</i>	<i>10</i>	<i>30</i>
<i>red sand</i>	<i>30</i>	<i>63</i>
<i>sand & gravel</i>	<i>63</i>	<i>80</i>
<i>red chert</i>	<i>80</i>	<i>84</i>
<i>small gravel sand</i>	<i>84</i>	<i>97</i>

WELL LOCATION:
 sec. *36* T. *1* N. R. *8* E
2 1/2 mile *SSW* *Prepers*
 (distance) (direction) (nearest town)

WELL PURPOSE: *Dring*
 (home, irrigation, municipal, industrial)

WELL COMPLETION DATA:


- (1) diameter (inches) *4"*
- (2) total depth (feet) *97*
- (3) static water level (feet) *65* below top of ground.
- (4) casing *Plastic* (material) *bottom* (depth)
- (5) screen *6'* (length) *91'* (depth to top)
4" (size) *Plastic* (material)
- (6) pump *3/4 Sub-15* (HP) *15* (yield gpm)
elect (type power)
- (7) electric log *no* (yes or no)

(organization running log)

(8) how well is it plugged *wooden plug*


DRILLERS REMARKS:
old 70' well insufficient

CODED

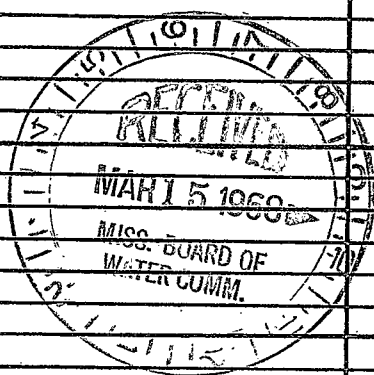

If well telescopes please sketch and show depths.

GROUND LEVEL

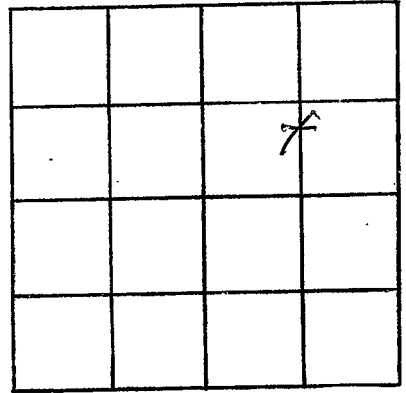

SECTION 36

Please indicate well location X.

ADDITIONAL INFORMATION

If more than one screen, show locations of each on sketch.