

PIKE CODE
 216
 8-68

MISSISSIPPI
 BOARD OF WATER COMMISSIONERS
 416 North State Street
 Jackson, Mississippi 39201

WATER WELL DRILLERS LOG

8-15-1968 Frederick Water Well Pike
 date well completed firm name county well located

LANDOWNER: W. L. Pines

description of formations encountered

from to

Maguire & MISS

<u>Top Soil & clay</u>	<u>0</u>	<u>10</u>
<u>Sandy</u>	<u>10</u>	<u>60</u>
<u>gravel & sand</u>	<u>60</u>	<u>80</u>
<u>Heavy gravel</u>	<u>80</u>	<u>125</u>

(mailing address)

WELL LOCATION:


sec. 1 T. 1 N. 8 E.
 S
8 miles SE of Maguire
 (distance) (direction) (nearest town)

WELL PURPOSE: home
 (home, irrigation, municipal, industrial)

WELL COMPLETION DATA:

- (1) diameter (inches) 4
- (2) total depth (feet) 160
- (3) static water level (feet) 75 below above top of ground.
- (4) casing plastic, 96
 (material) (depth)
4 if telescope see back.
 (size)
- (5) screen 21, 96
 (length) (depth to top)
4, sch 40
 (size) (material)
- (6) pump 3/4 hp, 8
 (type) (yield gpm)
elec
 (type power)
- (7) electric log no
 (yes or no)

CODED

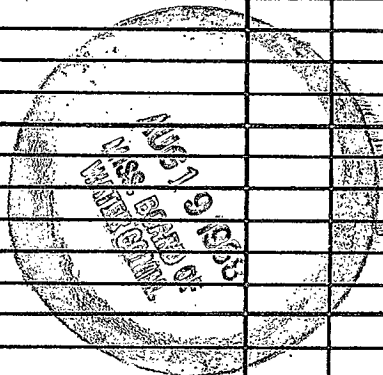


(organization running log)

(8) how well bottom plugged: Wid open

DRILLERS REMARKS:

If well telescopes please sketch and show depths.

GROUND LEVEL

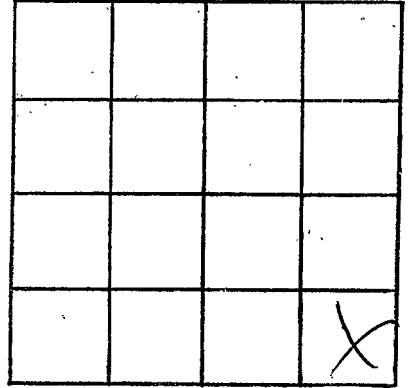

SECTION 1

Please indicate well location X.

ADDITIONAL INFORMATION

If more than one screen, show locations of each on sketch.