

CODED

Pike

L 17

7-68

MISSISSIPPI
 BOARD OF WATER COMMISSIONERS
 416 North State Street
 Jackson, Mississippi 39201

WATER WELL DRILLERS LOG

7-25

date well completed

1968 Fitzgerald Water Well

firm name

Pike

county well located

LANDOWNER: Alfonso Carter

description of formations encountered

from to

Magnolia Rt. MISS

(mailing address)

WELL LOCATION:

sec 2 T 1 N R 8 E

1/2 miles SE of Magnolia

WELL PURPOSE: home (home, irrigation, municipal, industrial)

WELL COMPLETION DATA:

(1) diameter (inches) 4

(2) total depth (feet) 155

(3) static water level (feet) 80 below top of ground.

(4) casing plastic 149 (material) (depth)

4 (size) if telescope see back.

(5) screen 6' 149 (length) (depth to top)

4" Sch 40 (size) (material)

(6) pump (HP) (yield gpm)

(type power)

(7) electric log NO (yes or no)


(organization running log)

(8) how well bottom plugged Wood Peg

DRILLERS REMARKS:


Top soil/clay	0	15
Red sand	15	40
gravel + sand	40	65
Heavy gravel	65	83
Chalk	83	142
gravel + sand	142	155
Chalk	155	

CODED

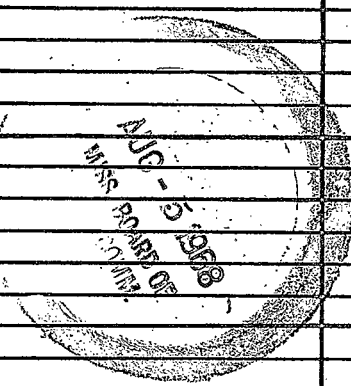

If well telescopes please sketch and show depths.

GROUND LEVEL

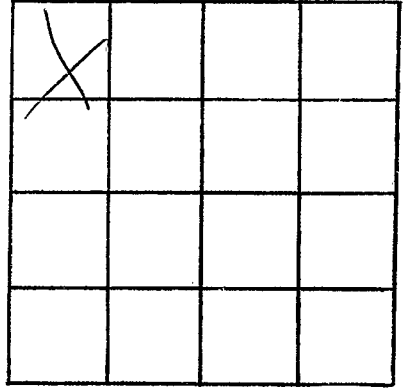

SECTION 2

Please indicate well location X.

ADDITIONAL INFORMATION

If more than one screen, show locations of each on sketch.