

Pike
 L 18
 7-68

CODED

MISSISSIPPI
 BOARD OF WATER COMMISSIONERS
 416 North State Street
 Jackson, Mississippi 39201

WATER WELL DRILLERS LOG

7-24 1968 Fitzgerald Water Well pike
 date well completed firm name county well located

LANDOWNER: Bulah Richie

description of formations encountered

from to

Magnolia Rt Miss

Top soil & Clay	0	10
Red Sand	10	25
Red gravel & sand	45	88
White Chalk	88	113
Gravel & sand	113	135

(mailing address)

WELL LOCATION:


sec S T 1 N ✓ R 8 E
5 miles So of Magnolia
 (distance) (direction) (nearest town)

WELL PURPOSE: home
 (home, irrigation, municipal, industrial)

WELL COMPLETION DATA:

- diameter (inches) 4
- total depth (feet) 133
- static water level (feet) 90 below top of ground.
- casing plastic, 127,
 (material) (depth)
4 if telescope see back.
 (size)
- screen 6", 127
 (length) (depth to top)
4, Sch 40
 (size) (material)
- pump _____ (HP) _____ (yield gpm)
 _____ (type power)
- electric log NO
 (yes or no)
 _____ (organization running log)
- how well bottom Wood Peg straggled


CODED

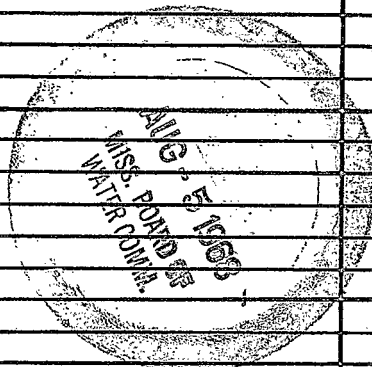

DRILLERS REMARKS:

If well telescopes please sketch and show depths.

GROUND LEVEL

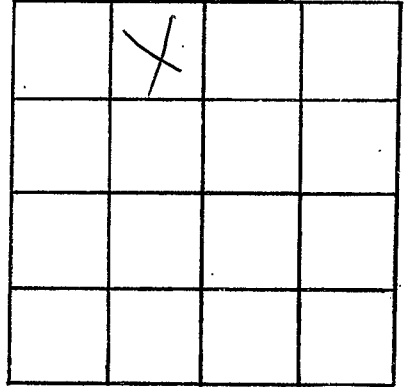

SECTION 5

Please indicate well location X.

ADDITIONAL INFORMATION

If more than one screen, show locations of each on sketch.