

PIKE

MISSISSIPPI BOARD OF WATER COMMISSIONERS

CODED

5-31-65

WATER WELL DRILLERS LOG

Date: 5-31, 1965, Driller: Chester Reeves County, Pike

(Name)

(1) Owner of Land: Donnie Bond
RFD, Osyka.
(Name)
(Address)

Description & Color of Materials
Sand, Clay, Red Clay, Shell, etc.

Thick-
ness
Feet

Depth
Feet

Surface clay 12 12
Red sand 75 87
yellow sand & gravel 10 97

(2) Location: 1/4, 1/4, Sec 36 T 1 R
15 miles East Osyka
(distance) (direction) (Nearest Town)

(3) Topography: Hilly
(Hilly) (Flat) (Level)

(4) Purpose of Well: Domestic
(Domestic Irrigation
Municipal, Industrial, Other)

Information upon completion of well:

(1) Diameter 4" inches.

(2) Total Depth 97 feet.

(3) Water Level 70 feet below top of ground.

(4) Cased to Bottom Size 4"

(5) Screen: Size 4", Length 7'

(6) Were any formations sealed against pollution?
yes, no.


If YES depth of formation

Why

Drillers Remarks: old well
sanded up.

Cannot locate
own

REEVES WELL & PUMP CO.
P. O. BOX 71 -- PHONE 684-1451
McCOMB, MISS.

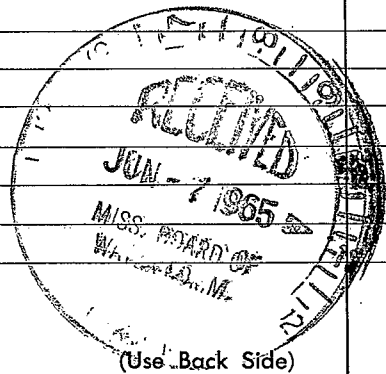

Well No.

