

CODED

MISSISSIPPI
BOARD OF WATER COMMISSIONERS
416 North State Street
Jackson, Mississippi 39201

CODED

WATER WELL DRILLERS LOG

10-8-

date well completed

19

68 Fitzgerald well dr

firm name

Pike

county well located

LANDOWNER: M. L. Fortenberry

description of formations
encountered

from

to

R.R. Magnolia Miss.
(mailing address)

Red clay

0

15

Red sand

15

40

Red gravel

40

60

Red sand

60

75

Coarse sand & gravel

75

86

13

71

WELL LOCATION:

sec. 23 T. 1 N R. 8 E
S W2 1/2 miles NNE of Bogalusa
(distance) (direction) (nearest town)

WELL PURPOSE:

(home, irrigation, municipal, industrial)

WELL COMPLETION DATA:

- (1) diameter (inches) 4
(2) total depth (feet) 86
(3) static water level (feet) 55 below
top of ground.

- (4) casing Plastic 80
(material) (depth)

4
(size) if telescope see back.

- (5) screen 6 80
(length) (depth to top)

4 Plastic
(size) (material)

- (6) pump 1/2 12
(HP) (yield gpm)

electric
(type power)

- (7) electric log yes (no)

(organization running log)


- (8) how well bottom plugged good

DRILLERS REMARKS:

NO. 120 1968
MISS. BOARD OF
WATER COMMISSIONERS

If well telescopes please
sketch and show depths.

GROUND LEVEL

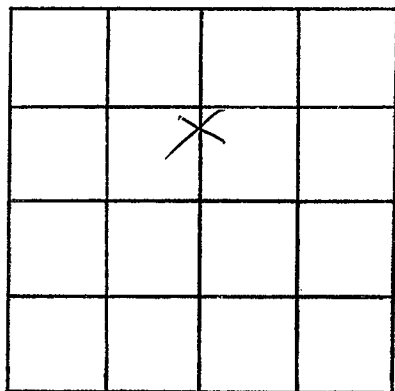

SECTION 23

Please indicate well location X.

ADDITIONAL INFORMATION

If more than one screen,
show locations of each on sketch.