



MISSISSIPPI  
 BOARD OF WATER COMMISSIONERS  
 416 North State Street  
 Jackson, Mississippi 39201

WATER WELL DRILLERS LOG

Pike CODEL  
L22  
10-7-68

10-7 1968 Fitzgerald well land Pike  
 date well completed firm name county well located

LANDOWNER:  
A. J. Martin  
R.R. Magnolia, Miss.  
 (mailing address)

WELL LOCATION:  
 sec. 19 T. 1 N. R. 9 E.  
2 miles W of River  
 (distance) (direction) (nearest town)

WELL PURPOSE: home  
 (home, irrigation, municipal, industrial)


WELL COMPLETION DATA:

- (1) diameter (inches) 4
- (2) total depth (feet) 122
- (3) static water level (feet) 70 below above top of ground.
- (4) casing Plaster 116,  
 (material) (depth)  
4 if telescope see back.  
 (size)
- (5) screen 6, 116  
 (length) (depth to top)  
4, plastic  
 (size) (material)
- (6) pump ? ?  
 (HP) (yield gpm)  
elec  
 (type power)
- (7) electric log Yes  
 (yes or no)  
 (organization running log)
- (8) how well bottom plugged wood peg

description of formations encountered	depth	
	from	to
<u>red clay</u>	<u>0</u>	<u>25</u>
<u>red sand</u>	<u>25</u>	<u>60</u>
<u>red gravel</u>	<u>60</u>	<u>90</u>
<u>red sand</u>	<u>90</u>	<u>110</u>
<u>course sand &amp; gravel</u>	<u>110</u>	<u>122</u>
		<u>25</u>
		<u>97</u>

REC - 9 1968

MISS. BD. OF WATER COMMISSIONERS

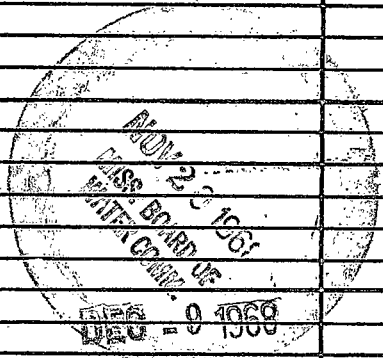


REC - 9 1968

MISS. BD. OF WATER COMMISSIONERS

DRILLERS REMARKS:

If well telescopes please sketch and show depths.

GROUND LEVEL

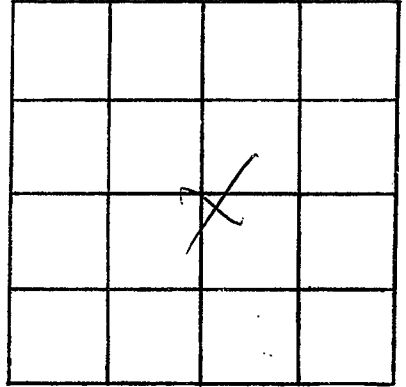

SECTION <sup>19</sup>26

Please indicate well location X.

ADDITIONAL INFORMATION

If more than one screen, show locations of each on sketch.