

CODED

MISSISSIPPI
BOARD OF WATER COMMISSIONERS
416 North State Street
Jackson, Mississippi 39201

CODED

WATER WELL DRILLERS LOG

Pike
L73
1-31-69

1-31 1969 68 Fitzgerald Water Well Pike
date well completed firm name county well located

LANDOWNER: Ed Brumfield
Osyka Rt Miss
(mailing address)

description of formations encountered	from	to
<u>red clay</u>	<u>0</u>	<u>20</u>
<u>red sand</u>	<u>20</u>	<u>70</u>
<u>red gravel</u>	<u>70</u>	<u>85</u>
<u>red clay</u>	<u>85</u>	<u>120</u>
<u>fine sand</u>	<u>120</u>	<u>130</u>
<u>fine silt & gravel</u>	<u>130</u>	<u>140</u>
<u>course sand & gravel</u>	<u>140</u>	<u>154</u>

WELL LOCATION:
sec 27 T L N 8 E 47
S W
5 miles E of Oxford
(distance) (direction) (nearest town)

WELL PURPOSE: no known
(home, irrigation, municipal, industrial)

WELL COMPLETION DATA:

- (1) diameter (inches) 4
- (2) total depth (feet) 154
- (3) static water level (feet) 70 below above top of ground.
- (4) casing 4" plastic 148
(material) (depth)
4 (size) if telescope see back.
- (5) screen 6" 148
(length) (depth to top)
4" plastic
(size) (material)
- (6) pump ? ?
(HP) (yield gpm)
4hp
(type power)
- (7) electric log No
(yes or no)
(organization running log)
- (8) how well bottom plugged covered

CODED


FEB 13 1969

MISS. REG. OF
WATER CONTROL

DRILLERS REMARKS:

If well telescopes please sketch and show depths.

GROUND LEVEL

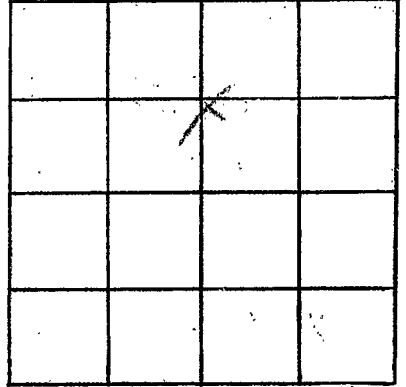

SECTION 27

Please indicate well location X.

ADDITIONAL INFORMATION

If more than one screen, show locations of each on sketch.