

Ooke
 L24
 2-11-69

CODED

MISSISSIPPI
 BOARD OF WATER COMMISSIONERS
 416 North State Street
 Jackson, Mississippi 39201

WATER WELL DRILLERS LOG

Pike

FEB-11 19 *69* *H. L. VARNADO & SONS, INC.* firm name *Pike* county well located

LANDOWNER: *Joe CARTER*
Rt. 1 - Box 415 - A -
OSYKA - MISS
 (mailing address)

description of formations encountered	from	to
<i>CLAY</i>	<i>0</i>	<i>40</i>
<i>Red SAND</i>	<i>40</i>	<i>60</i>
<i>SAND & GRAVEL</i>	<i>60</i>	<i>100</i>
<i>CLAY & GRAVEL</i>	<i>100</i>	<i>110</i>
<i>WATER SAND & GRAVEL</i>	<i>110</i>	<i>130</i>

WELL LOCATION:
 sec. *1* T. *1* N. R. *8* E
6 miles *NE* of *OSYKA*
 (distance) (direction) (nearest town)

WELL PURPOSE: *Home*
 (home, irrigation, municipal, industrial)

WELL COMPLETION DATA:

- (1) diameter (inches) *2"*
- (2) total depth (feet) *130'*
- (3) static water level (feet) *70'* below top of ground.
- (4) casing *2" Plastic*, *116'*
 (material) (depth)
 _____ if telescope see back.
 (size)
- (5) screen *14"*, *116'*
 (length) (depth to top)
2", *PLASTIC*
 (size) (material)
- (6) pump *3/4*, *330*
 (HP) (yield gpm)

 (type power)
- (7) electric log _____
 (yes or no)

 (organization running log)
- (8) how well bottom plugged *Brown*
BACK WASH VALVE

CODED

REC-3
MAR 20 1969
MISSISSIPPI BOARD OF WATER COMMISSIONERS

DRILLERS REMARKS: *VERY Good*


If well telescopes please sketch and show depths.

GROUND LEVEL

1 1/2" PVC PIPE

2"

1/4" Screen

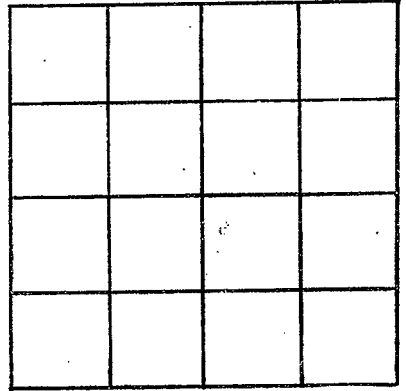

SECTION 1

Please indicate well location X.

ADDITIONAL INFORMATION

If more than one screen, show locations of each on sketch.